

SECTION

30


SE SW

TOWNSHIP 39S, RANGE 37E, W. M.

11-4194

LITTLE SAGEHEN
SPRING

North

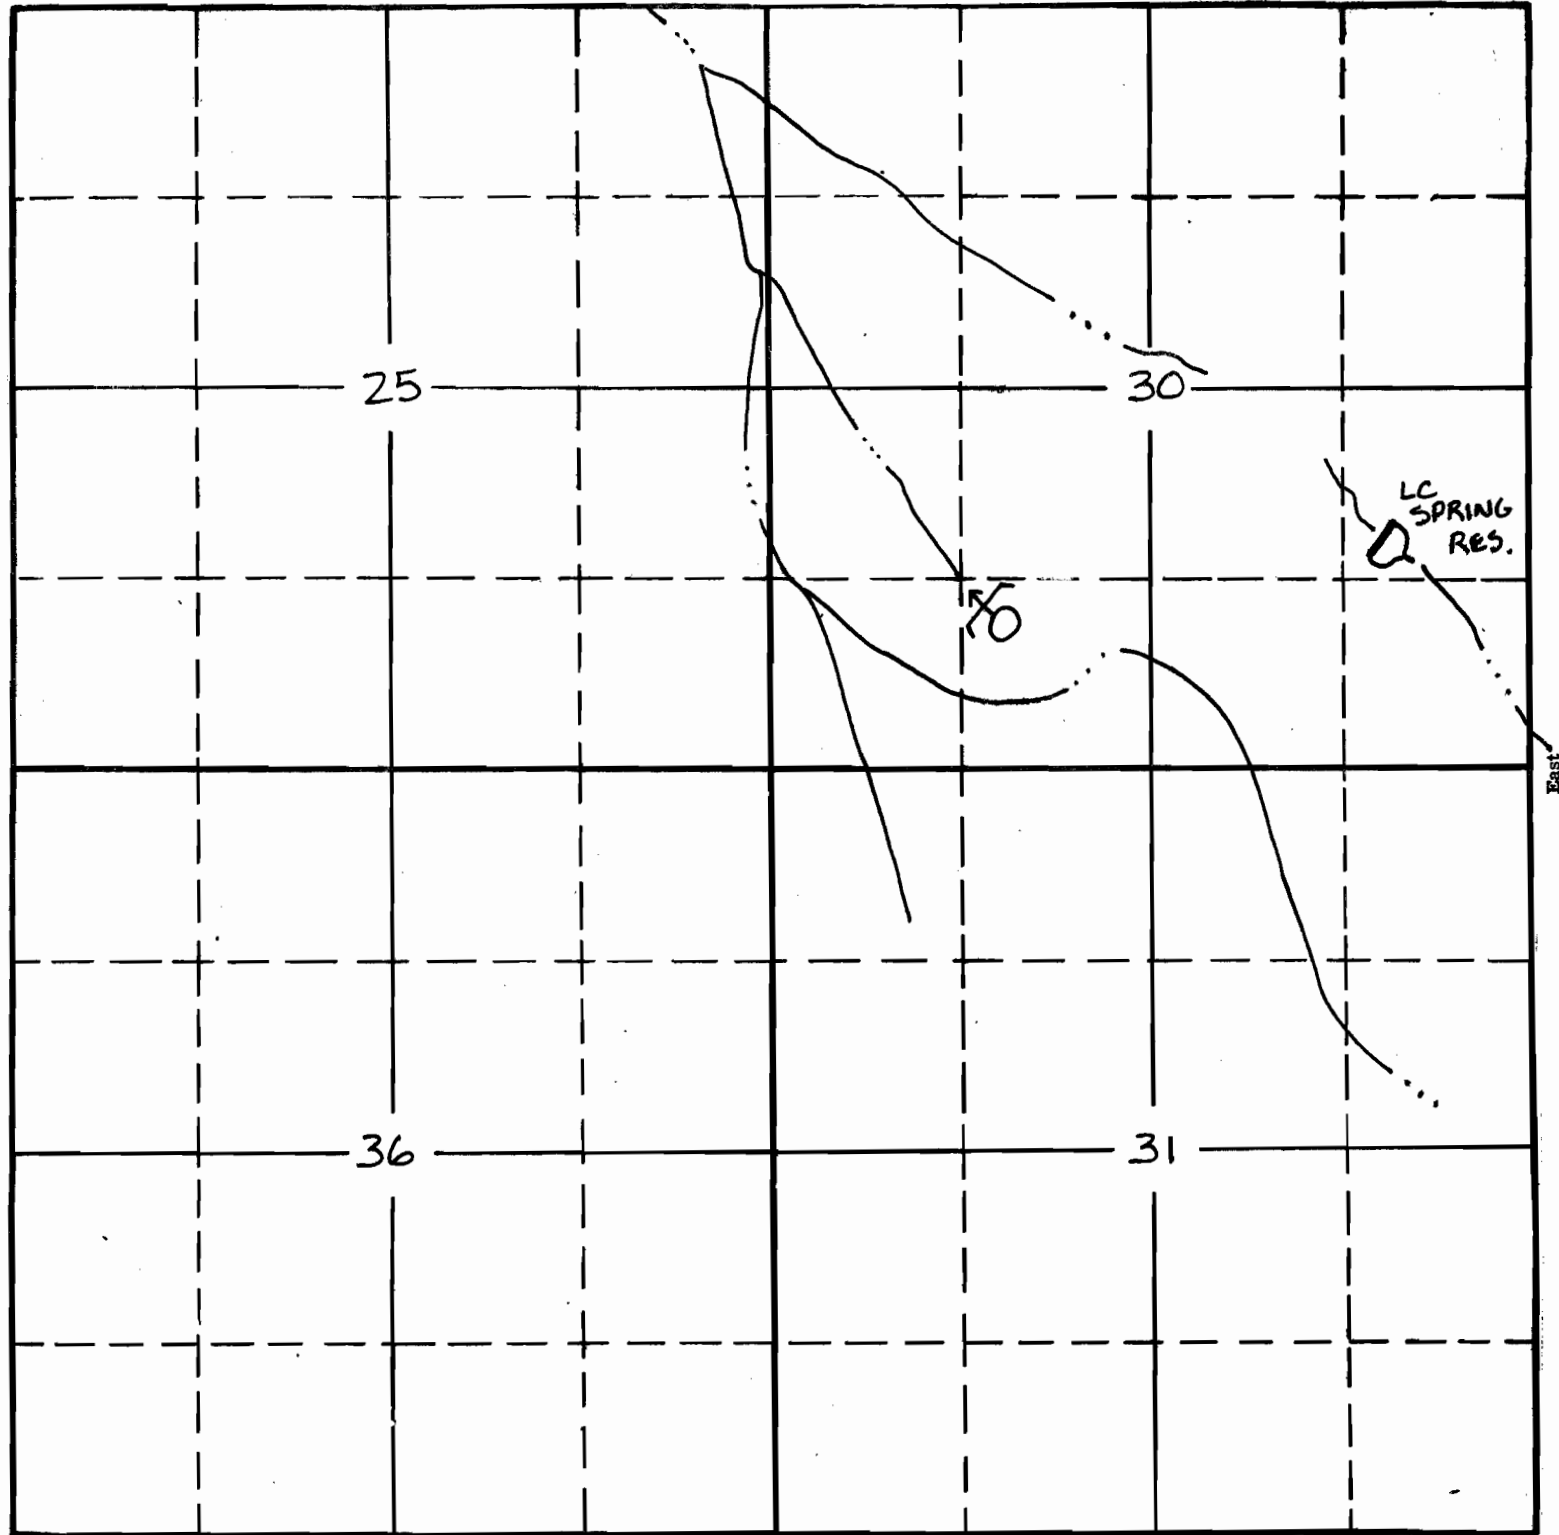

South

Application No. 66540
Permit No. 50557

RECEIVED

APPLICATION No.
PERMIT No.
SEP 11 1983
WATER RESOURCES DEPT.
SALEM, OREGON