


SECTION

30
SE NW

09-4054
FRAZIER SPRING

TOWNSHIP 32 S, RANGE 32 3/4 E, W. M.

North

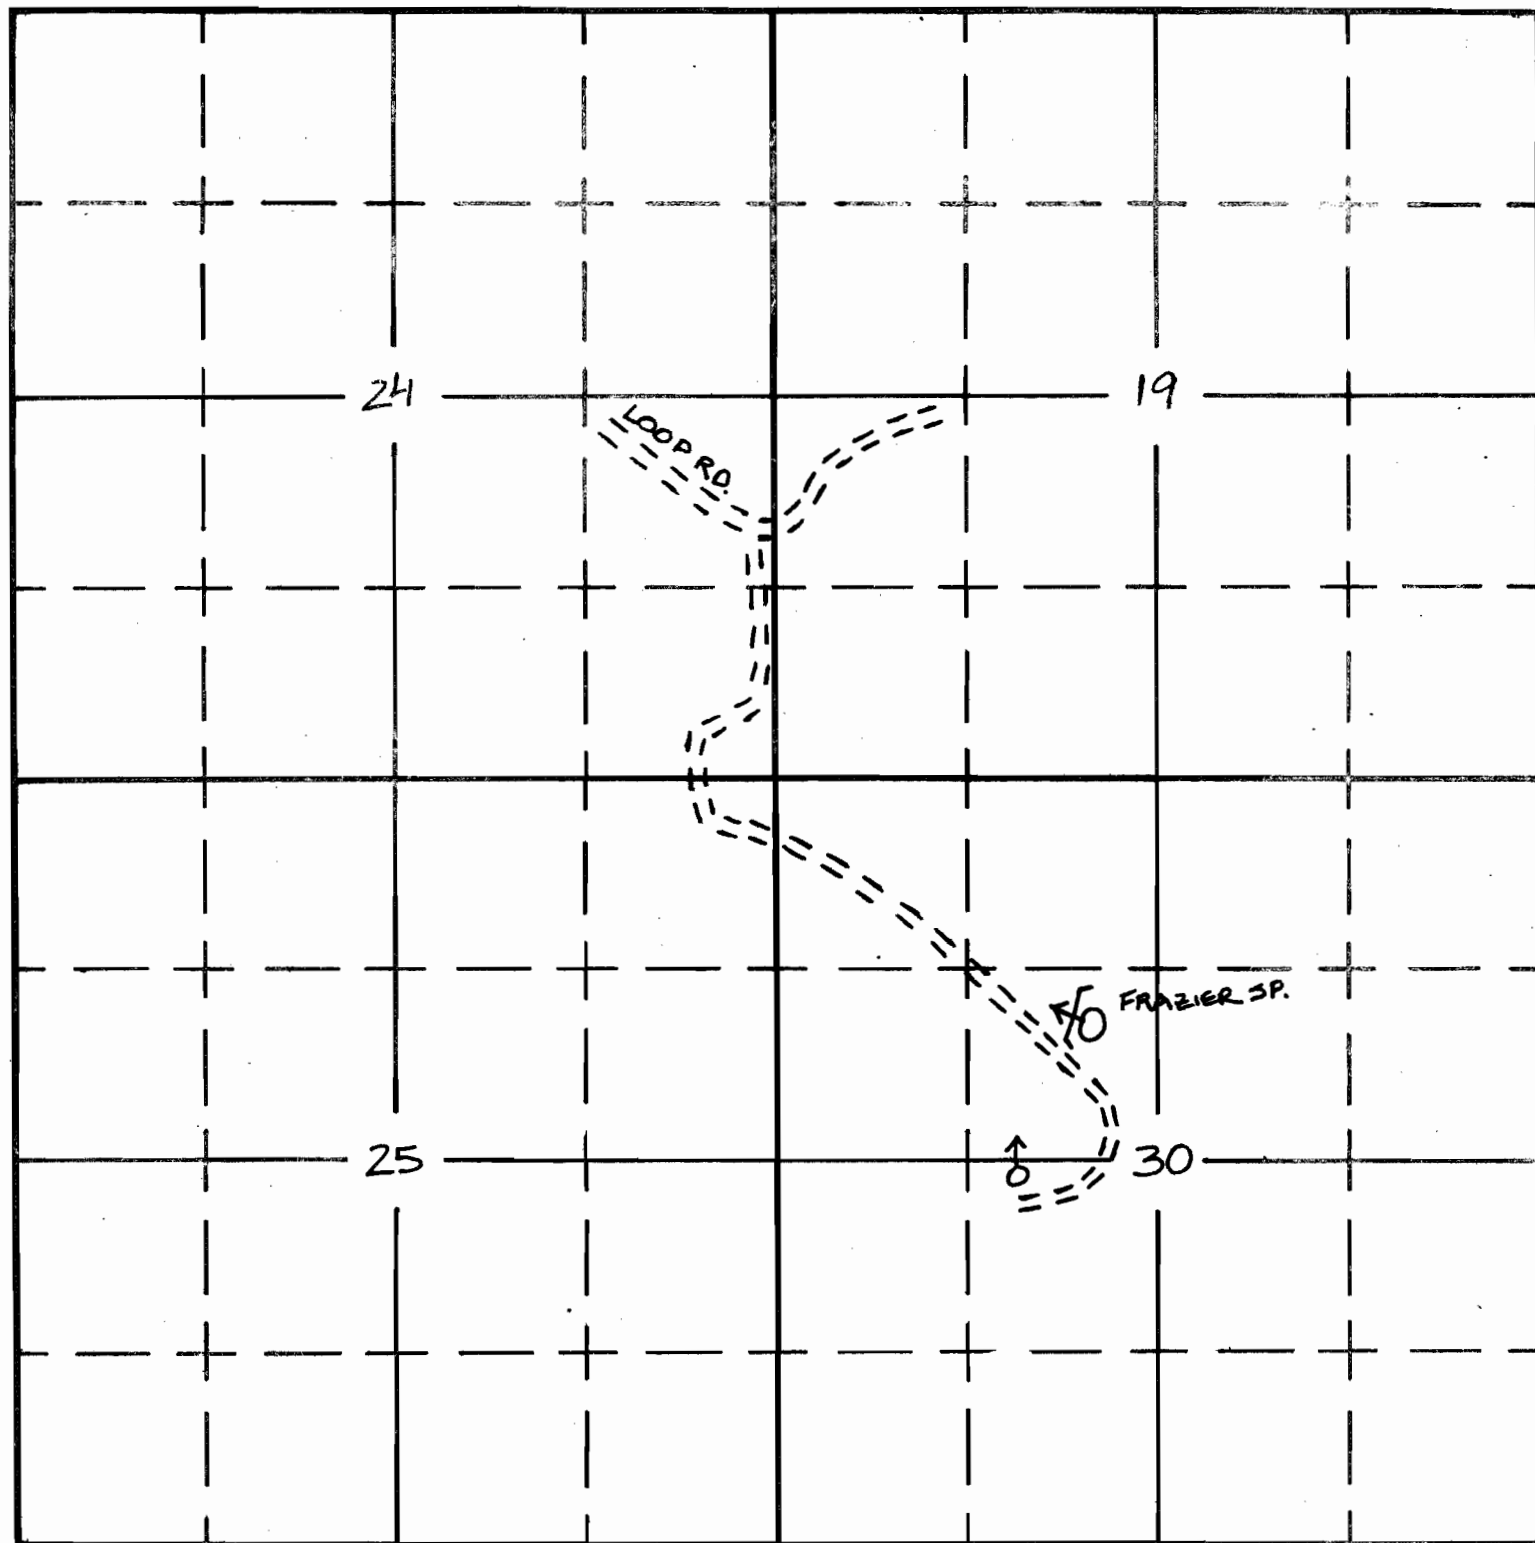

South

Application No. 66549
Permit No. 50564

SL. 11983
CES DEPT.
SALEM, OREGON