


NW SW

Burke Spring  
11-5126

TOWNSHIP 37 S., RANGE 33 E., W. M.

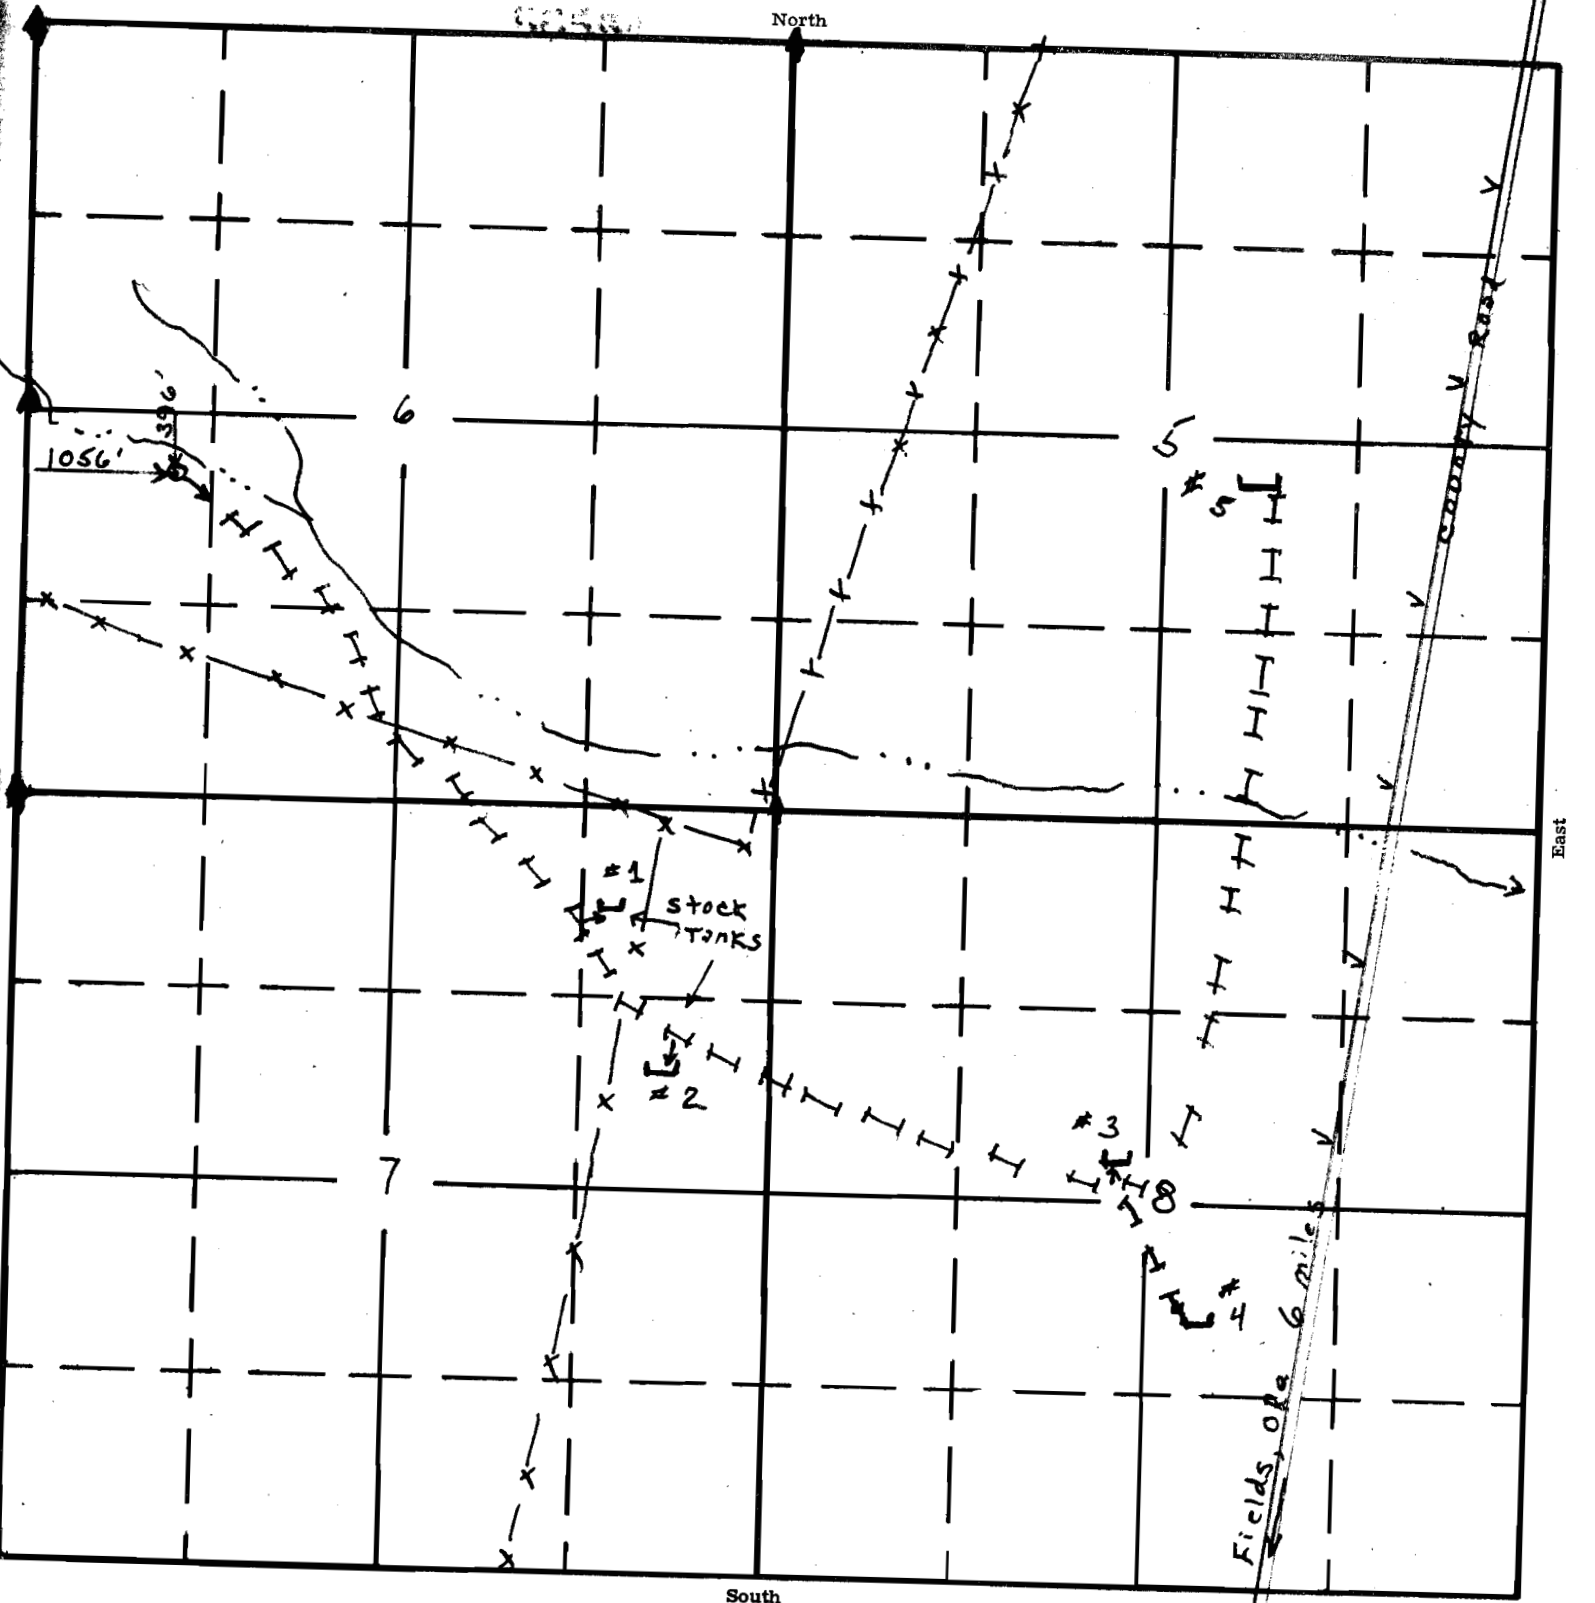

Application No. 66354  
Permit No. 50565

SEP 21 1983  
SALEM, OREGON