


SECTION

Al's Canyon Spring
11-4057

13
NW NW

TOWNSHIP 41S, RANGE 36E, W. M.

North

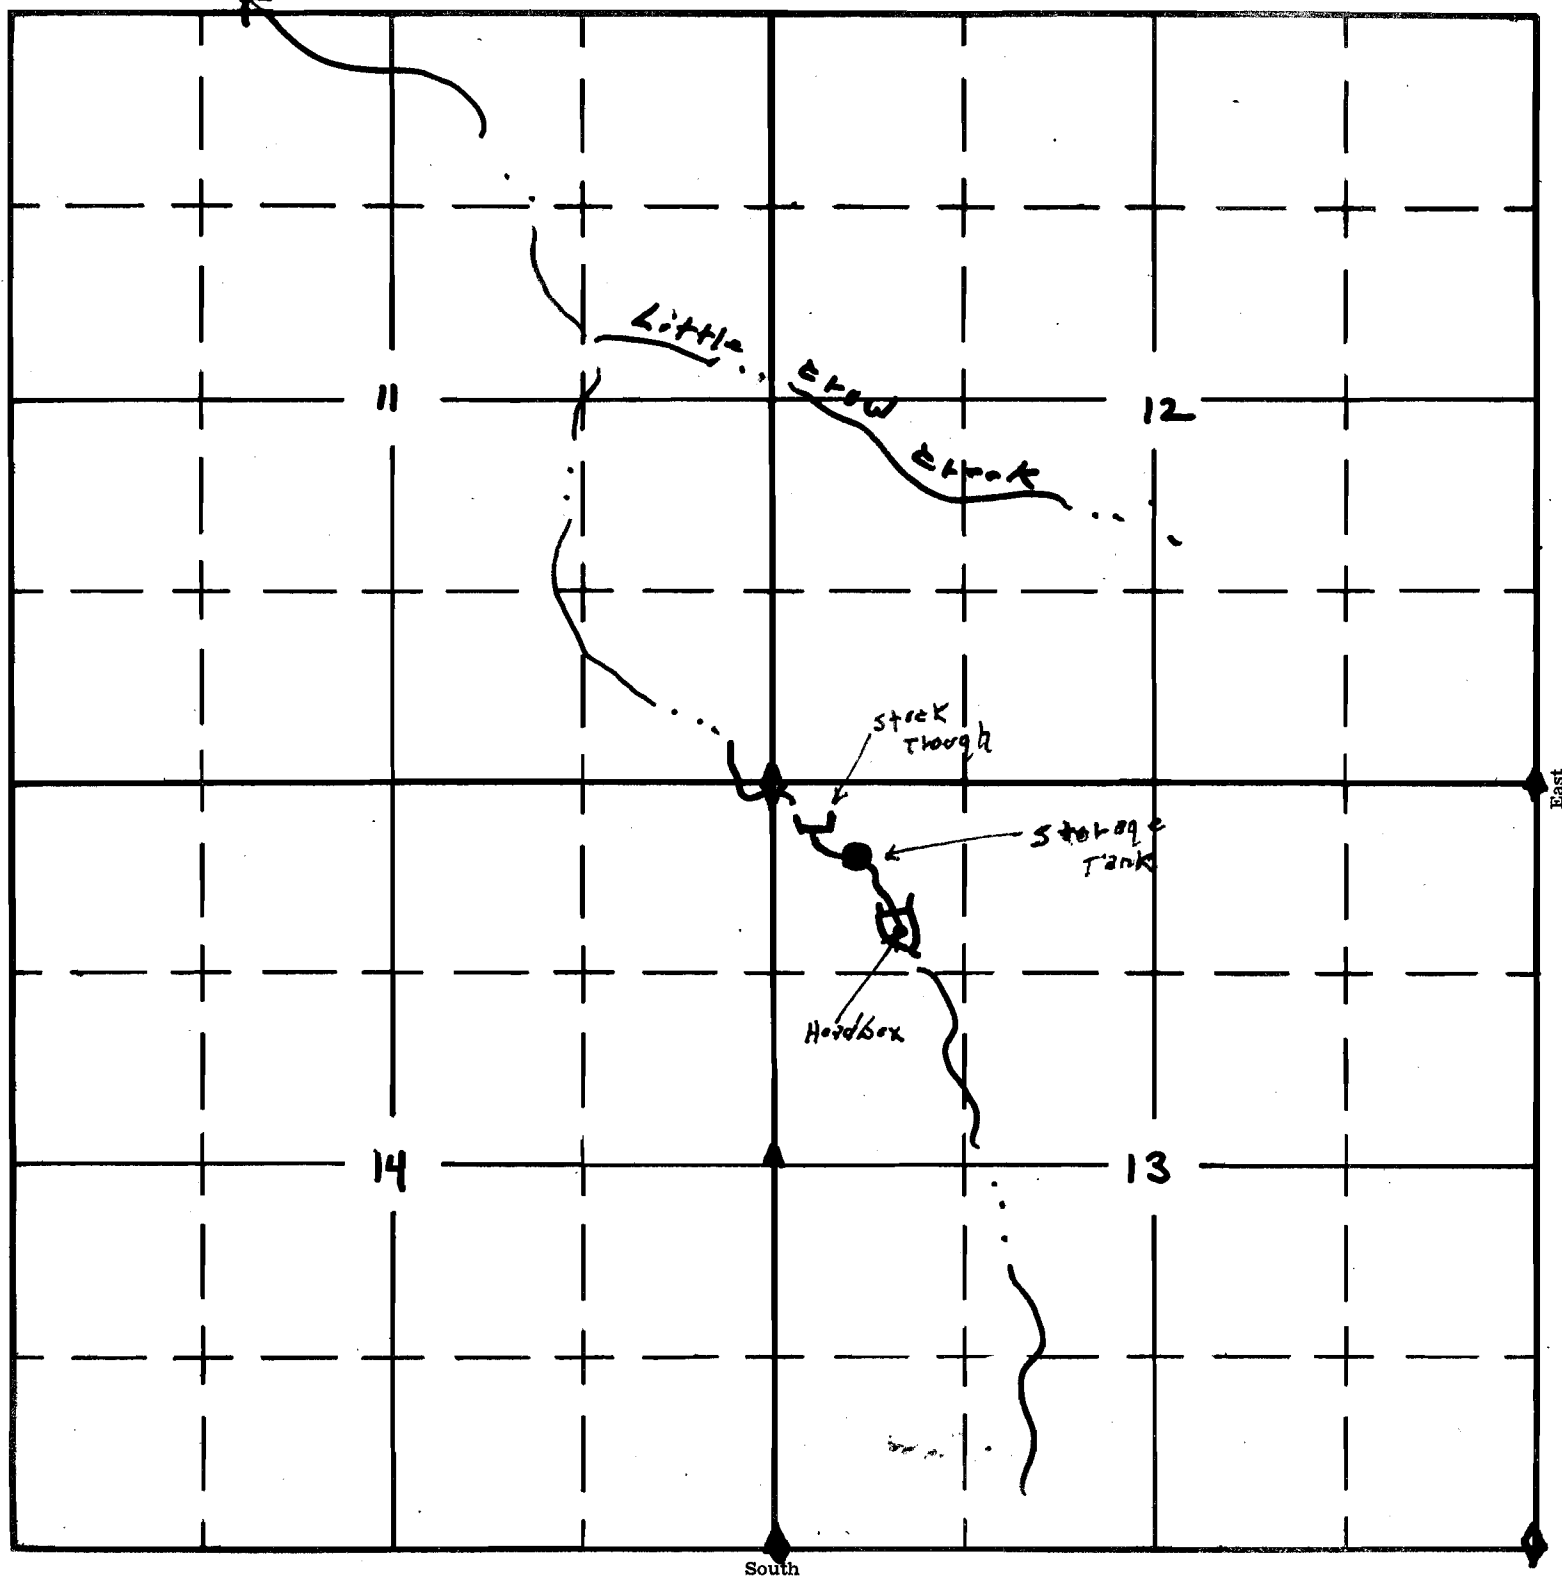

Application No. 66557
Permit No. 50566

SL. 11983
CES DEPT.
SALEM, OREGON