

SECTION


8

NE NE

11-4098

Horsehoe Corral Spring

TOWNSHIP 40S, RANGE 38E, W. M.

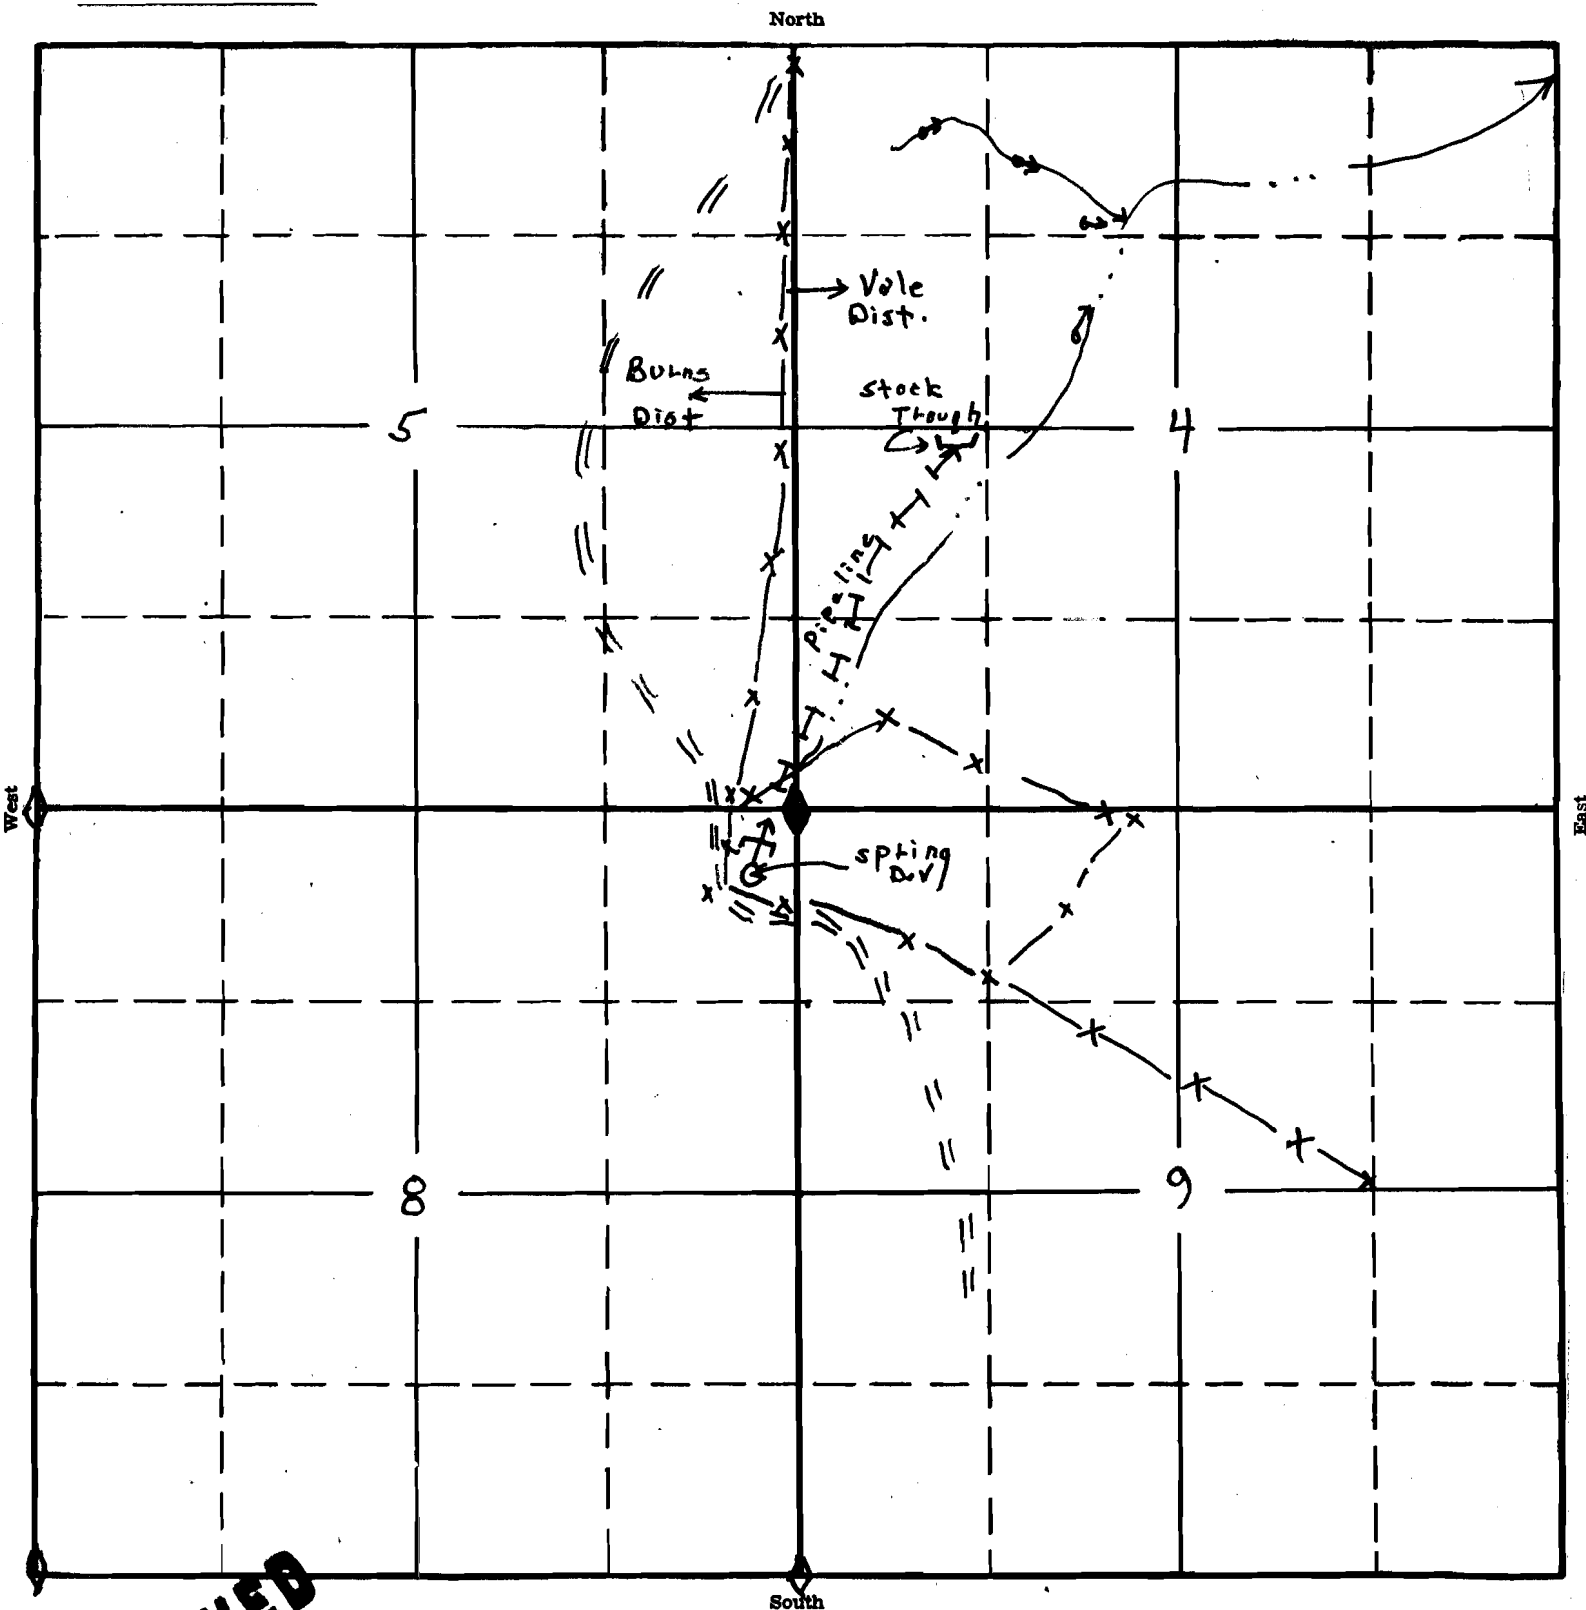

RECEIVED
SEP 21 1983
WATER RESOURCES DEPT.
SALEM, OREGON

Application No. 66564
Permit No. 50569

APPLICATION No.
PERMIT No.