

SECTION

13


SESW

TOWNSHIP 38S, RANGE 34E, W. M.

11-4965

RALPH KERR
SPRING

North

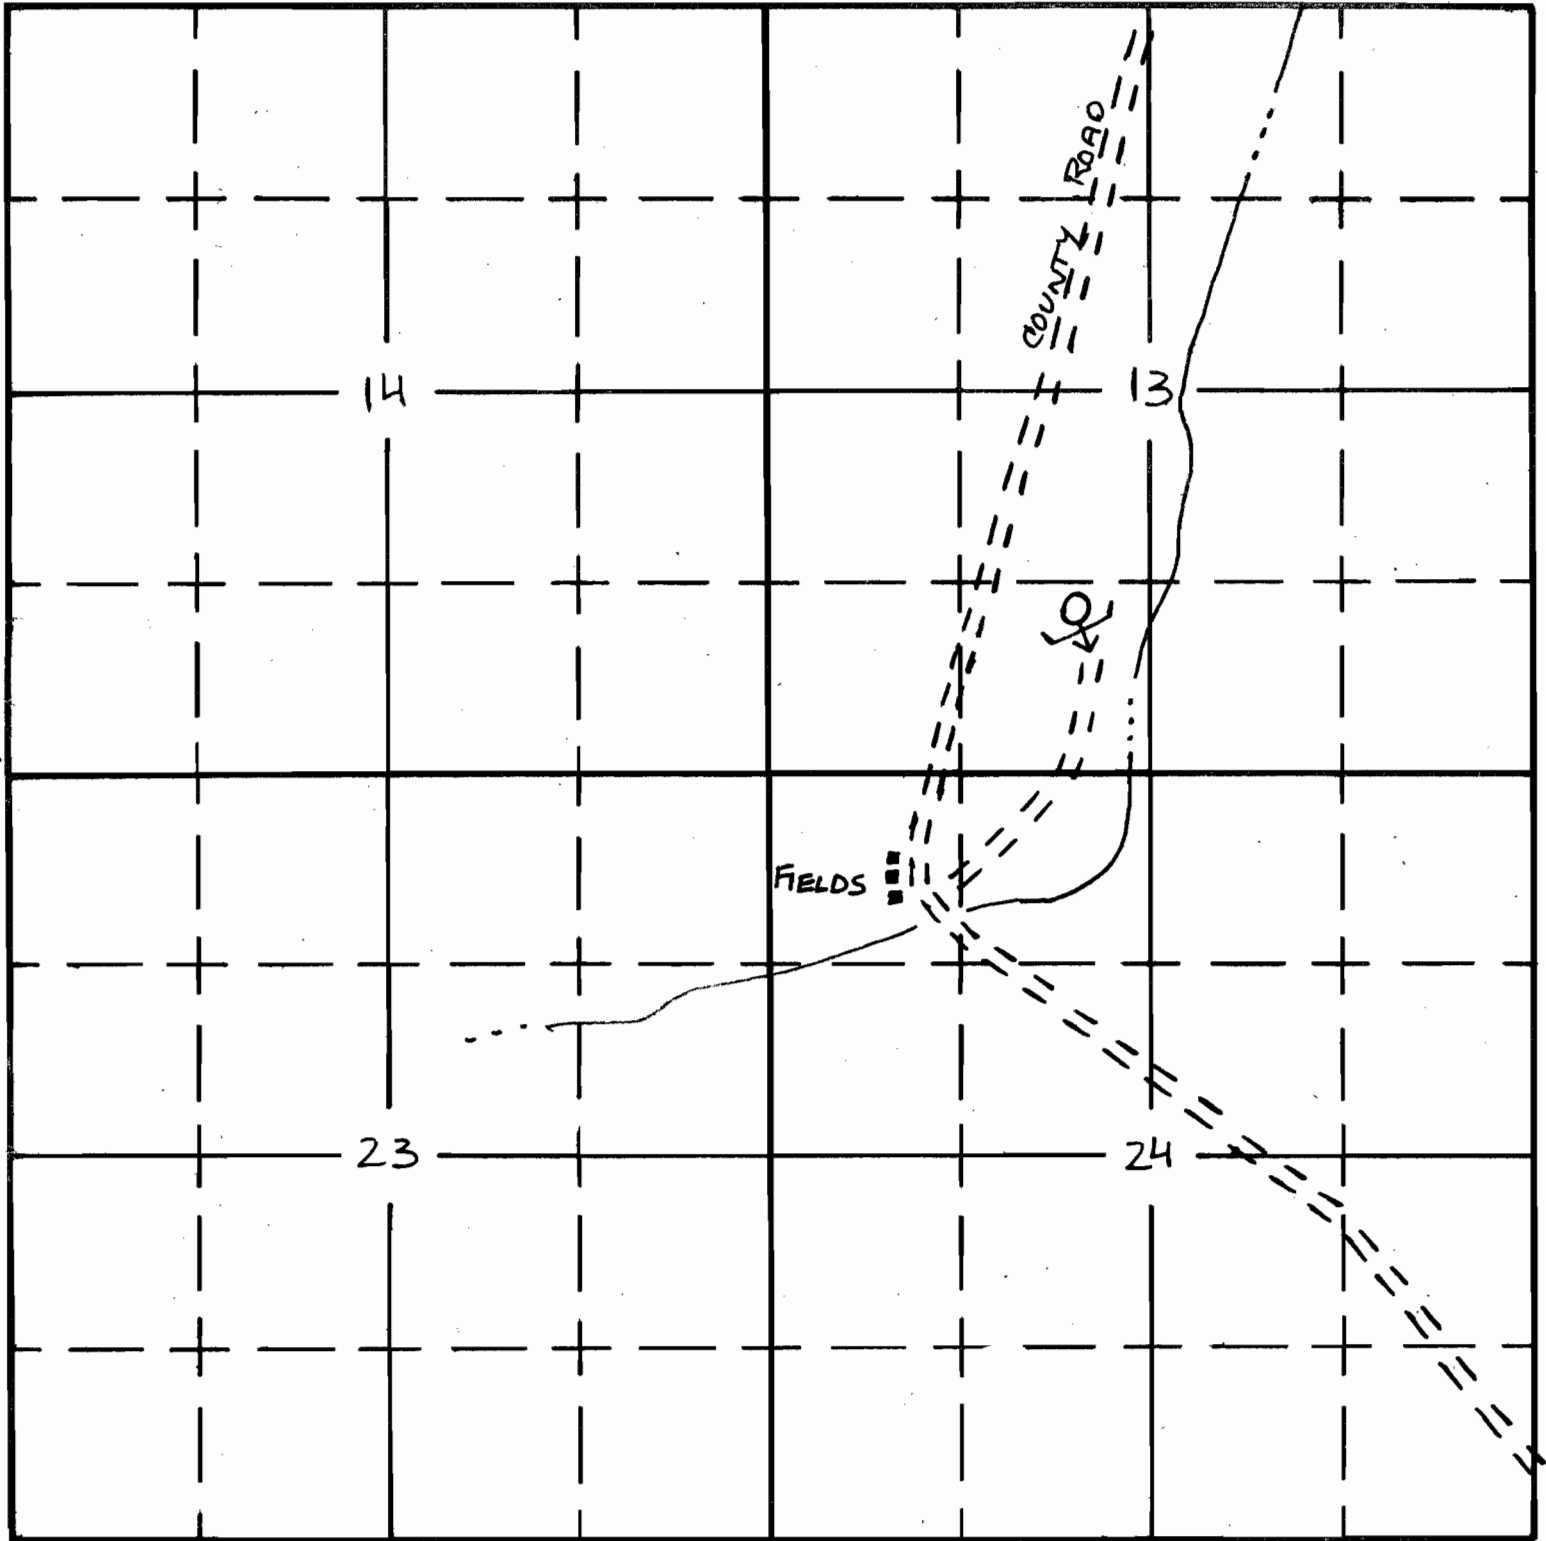

South

66580

Application No.

66580

Serial No. 50577

SEP 1 1983
CES DEPT.
SALEM, OREGON