

SECTION


24 (1/2 sec.)

SW NE

TOWNSHIP 41S, RANGE 37E, W. M.

11-4202
TROUT CREEK
SPRING #15

North

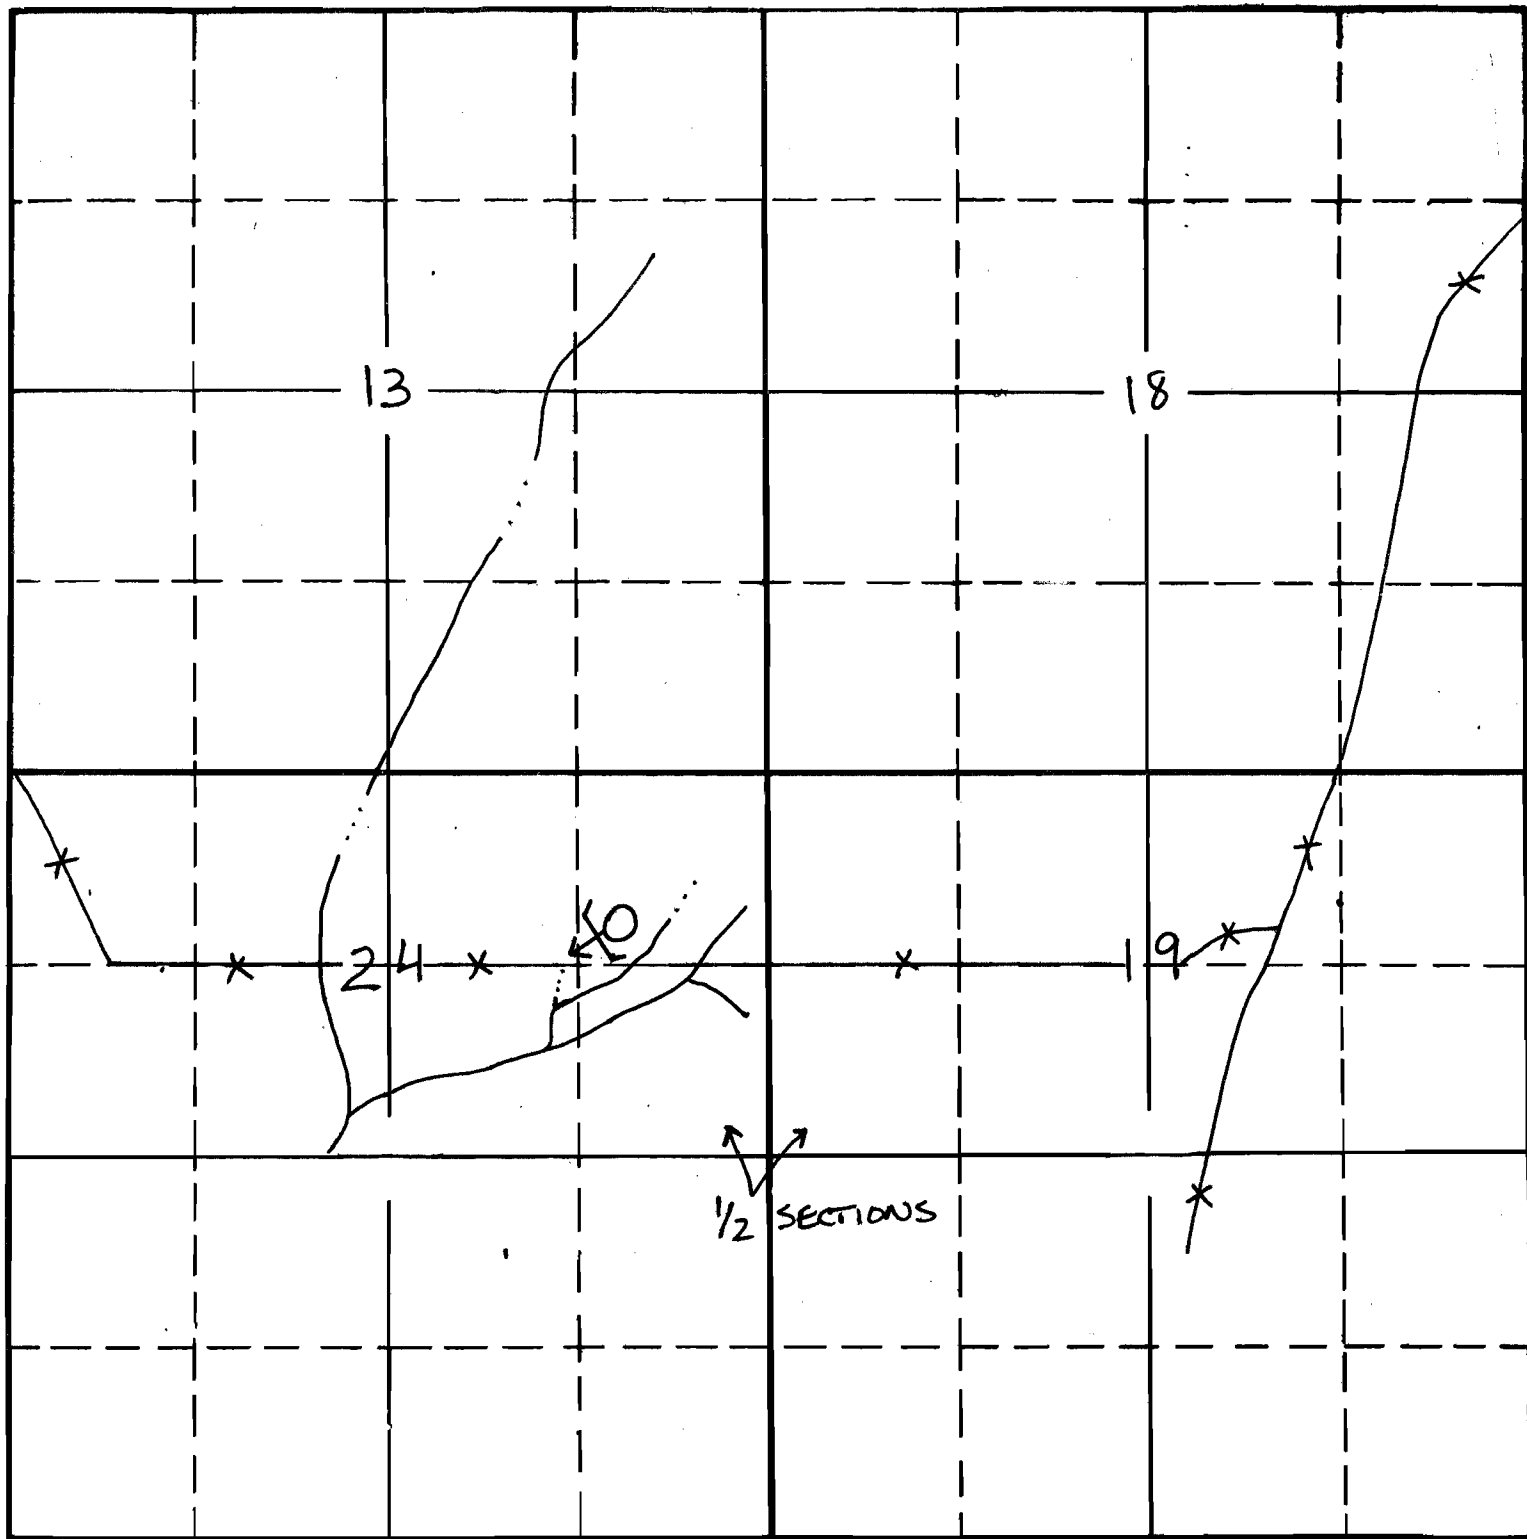

South

Application No. 66538
Permit No. 50781

APPLICATION No.
PERMIT No.
SE. 1983
SAL. RES. DEPT.
SALEM, OREGON