

FORM 712-207
March 1961

DEPARTMENT OF THE INTERIOR
BUREAU OF LAND MANAGEMENT

SECTION

Oregon State Water Filings


Stud pile Spring
Dugout.
09-5490

10 SE NW

TOWNSHIP 37S, RANGE 32 3/4 E, W. M.

North

Application No. R68571
Permit No. R11033

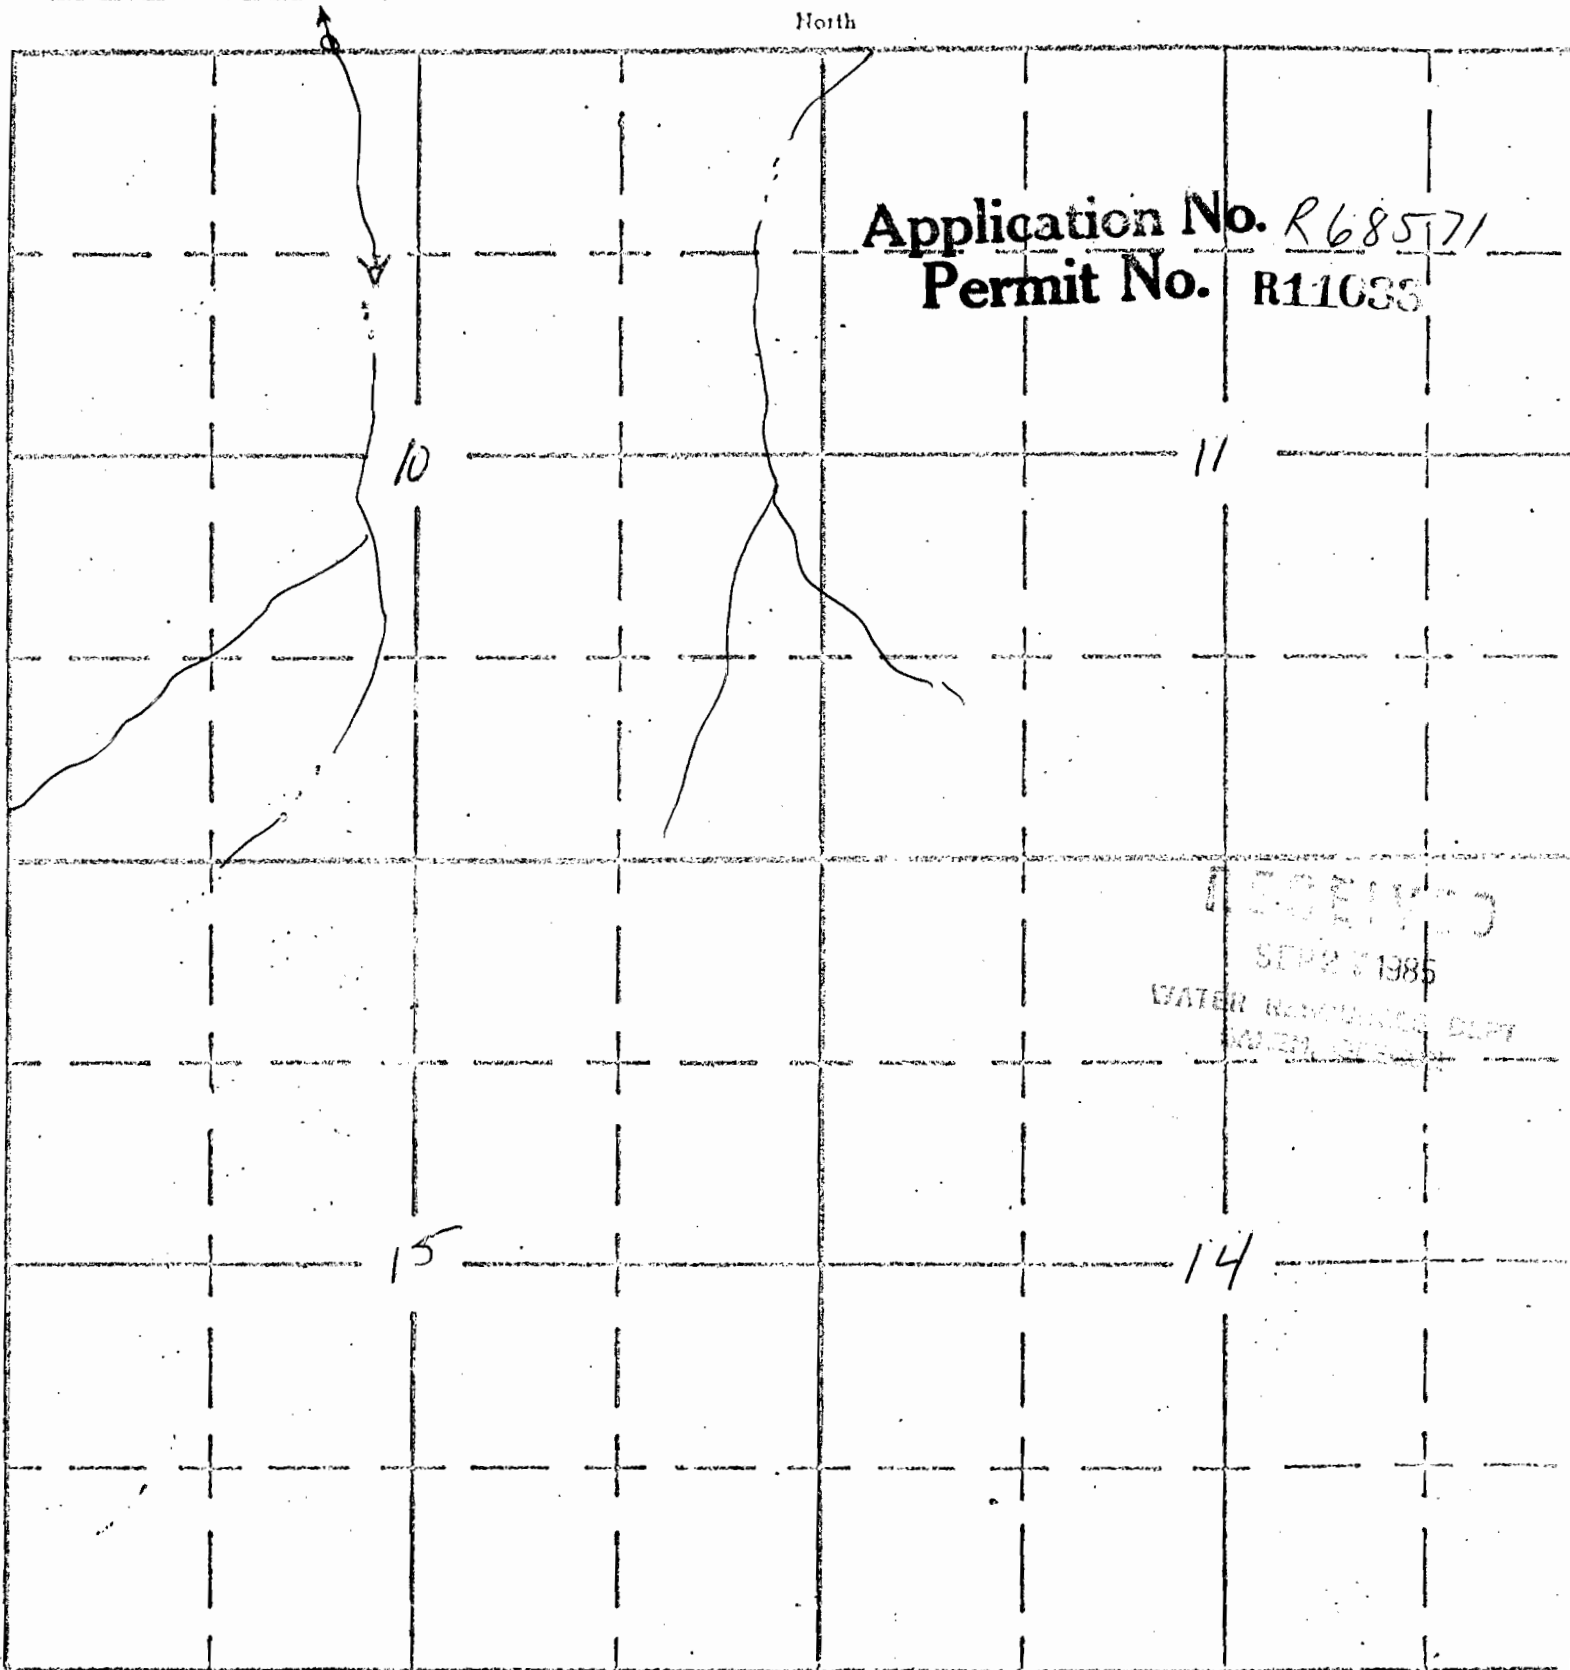

South

RECEIVED
SEP 27 1985
WATER RESOURCES DEPT
WATER DIVISION

APPLICATION NO.