


66454

RECEIVED

MAY 17 1976

WATER RESOURCES DEPT  
SALEM, OREGON

R 17 E

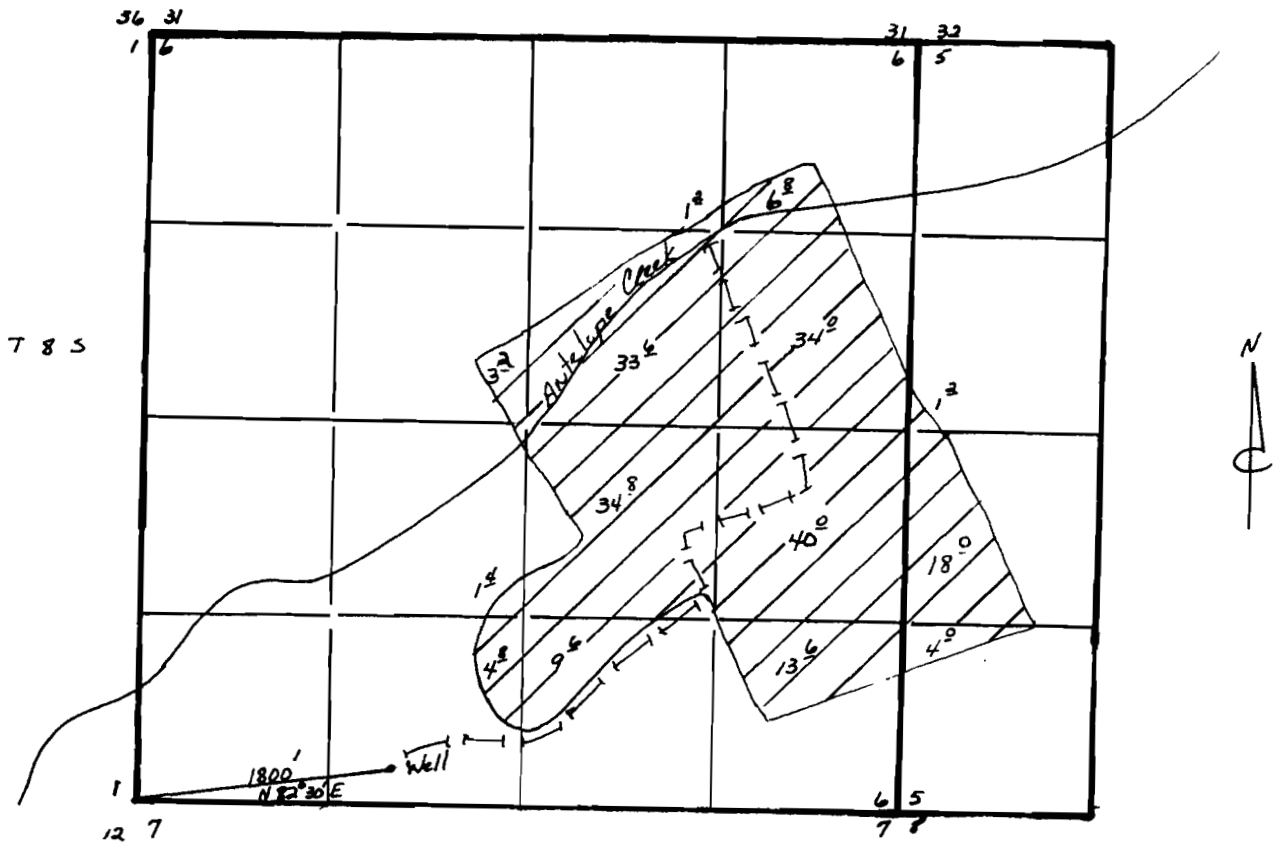

Scale: 4 inches/mile

Clarence E. BROWN

P.O. Box 56

Antelope, Oregon 97001

Application No. G-7320  
Permit No. G 6889

G-1-889