


T.13S., R.16E., W.M.

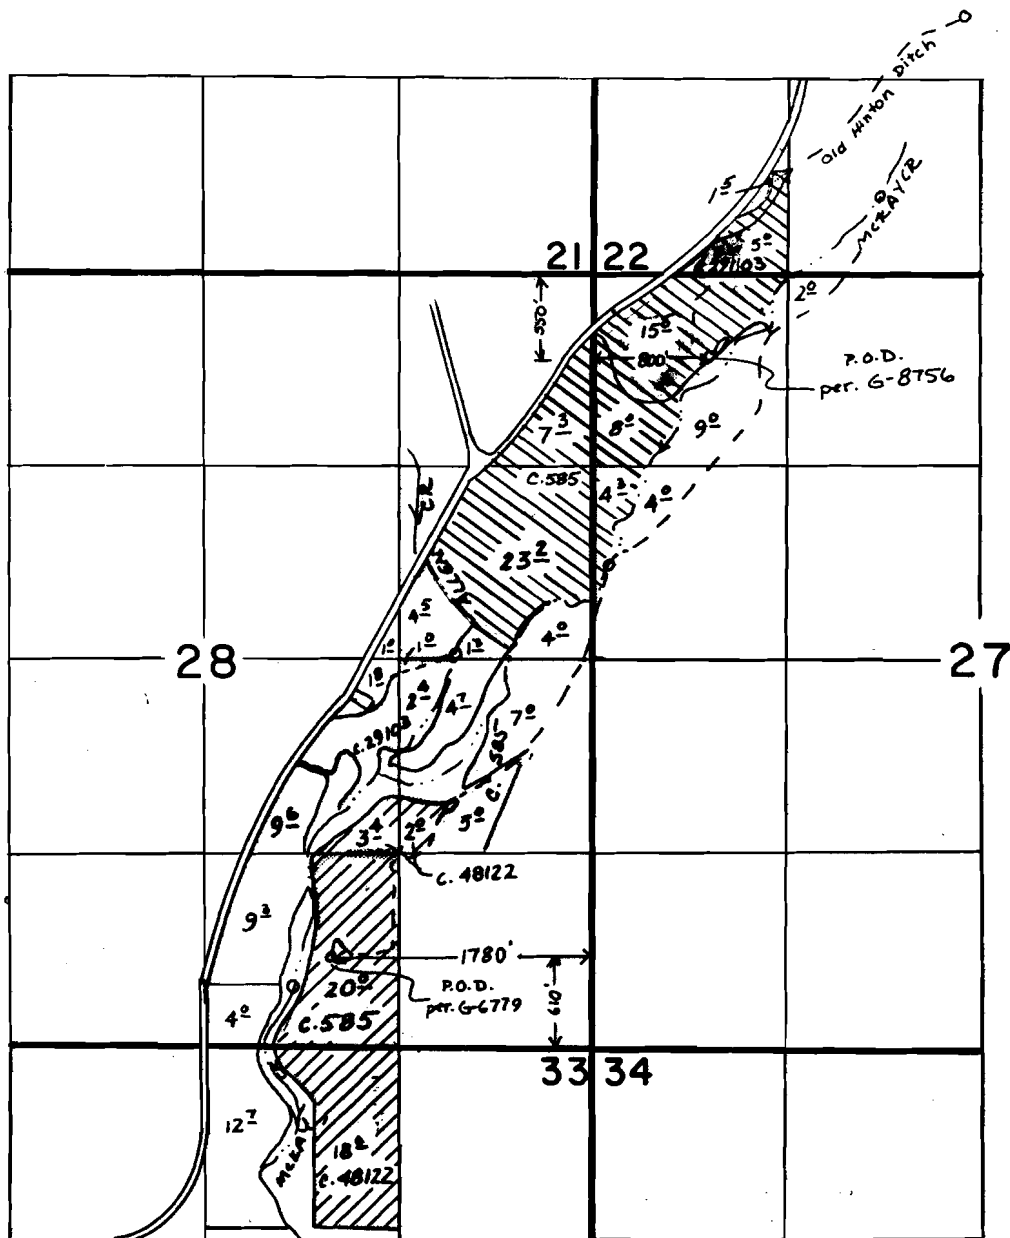



SCALE: 1"=1320'

### FINAL PROOF SURVEY UNDER

G-9322                      G-8756  
 Application No. G-7350 Permit No. G-6779  
 IN NAME OF

J. DOUG DUNN

Surveyed OCT. 16 19.86, by L. OLSON

-  Cert # 66456
-  Cert # 66455

Rec'd 7-29-91 WDH/11