



T.13S., R.16E., W.M.

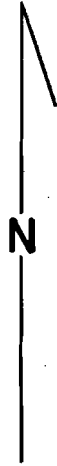

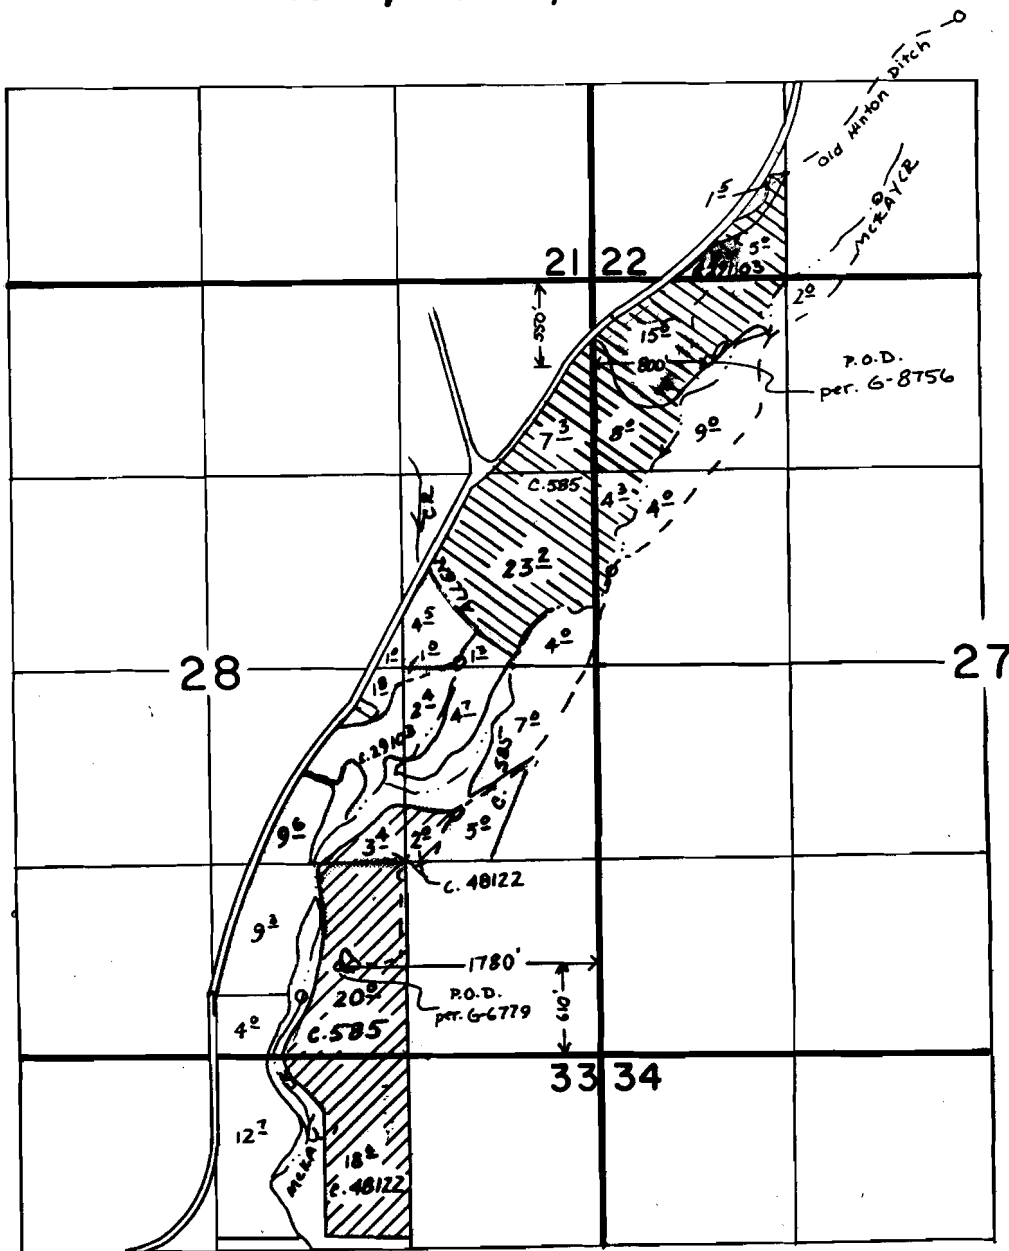

SCALE: 1"=1320'

FINAL PROOF SURVEY UNDER

Application No. G-9322 Permit No. G-8756
G-7350 Permit No. G-6779
 IN NAME OF

J. DOUG DUNN

Surveyed OCT. 16 1986, by L. OLSON

-  Cert # 66456
-  Cert. # 66455

Rec'd 7-29-91 WD#11