


SCALE 1" = 50'


$\Delta = 55^\circ 56' 10''$   
 $R = 286.47'$   
 $\bar{s} = 152.11'$   
 $L = 279.67'$   
 $LC = 264.01'$

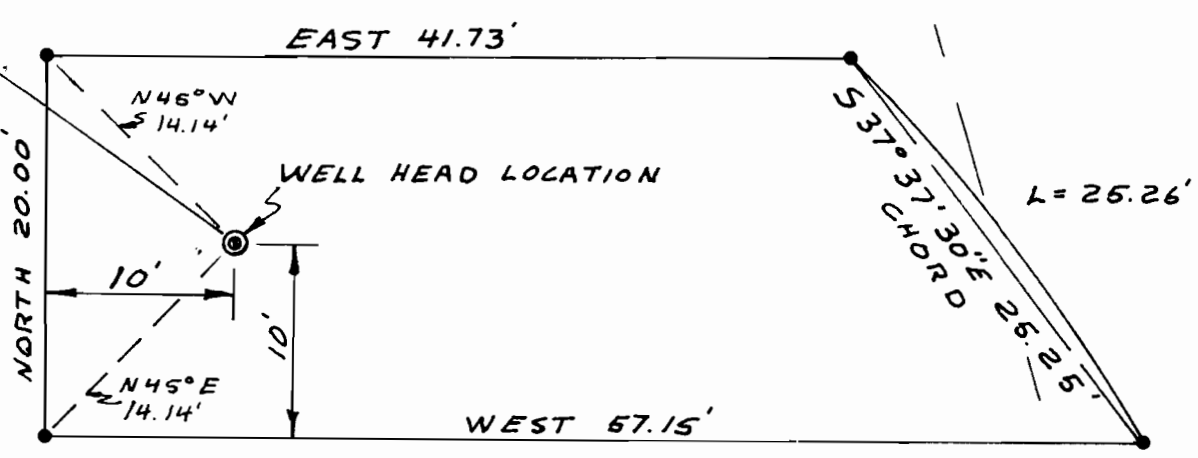

INSERT SCALE 1" = 10'

BASIS OF BEARING C.S. 12339

- MONUMENT FOUND
- MONUMENT SET 1/2" I.R.
- MONUMENT OF RECORD

 

G.K. ATTIG AND ASSOCIATES CONSULTING ENGINEERS  
 OREGON

SCALE	DATE	SHEETS
WELL SITE SURVEY FOR DEERHORN WATER DISTRICT		
S.W. 1/4 SECT. 17, TWP. 17S, R. 1E, W. 1M.		
JOB No.	DRGN. V.V.	CHD. L.F.
DESIGN.	DATE	SHEETS
REV.		

17 SOUTH 1/4 CORNER 20 SECTION 17

17-15-17