





T.19S., R.43&44E.,W.M.

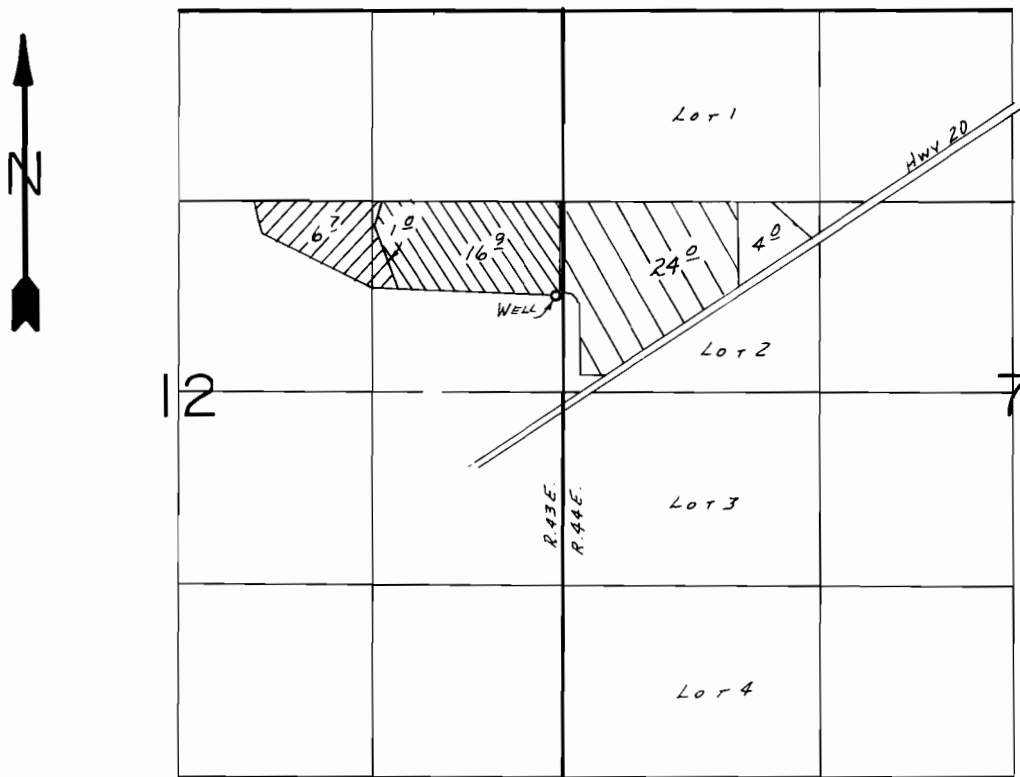

WELL LOC.: 1960'S. 1/4 50' W. FROM NE COR. SEC. 12.

-  G-8736 Primary
 -  G-8736 Supplemental
 -  G-11090
- SCALE: 1" = 1320'

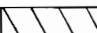FINAL PROOF SURVEY
UNDER

Application No. G-8736 G-8403
G-11090 Permit No. G-10302...
IN NAME OF

JACK D. PRESSLEY

Surveyed Apr. 30... 19.86, by L.M.TOLL.....