


G8312
66465

T.34S., R.19E., W.M.

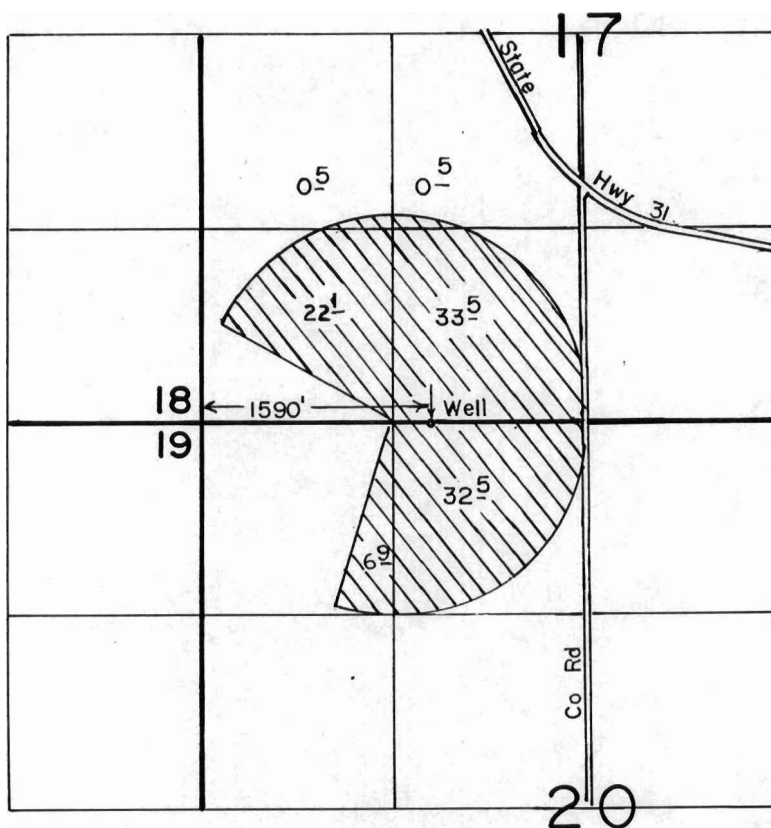

SCALE: 1"=1320'

FINAL PROOF SURVEY UNDER

Application No. G-8312. Permit No. G-8312.....
IN NAME OF

.....J-SPEAR.....RANCH.....COMPANY...

Surveyed APRIL 4.. 1990., by B.W.BISHOP.....