


T. 10 S., R. 38 E., W.M.

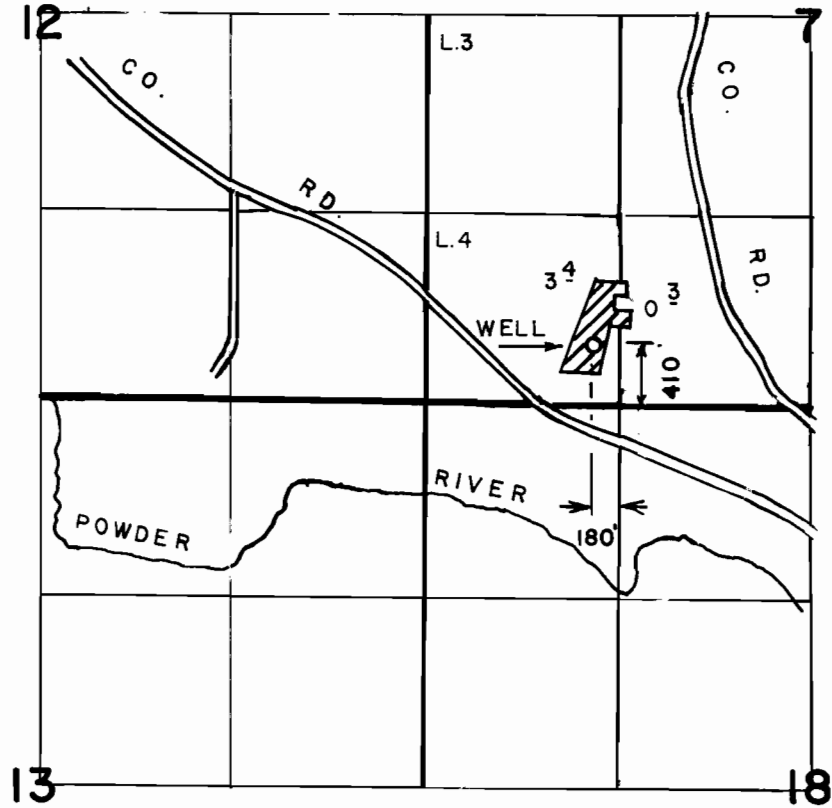

1" = 1320'

FINAL PROOF SURVEY
UNDER

Application No. G-8965 Permit No. G-8343
IN NAME OF

RICHARD A. JAMESON

Surveyed NOV. 6, 1989, by V.L. CHURCH.

3-19-90
41001-279-129A
DSM