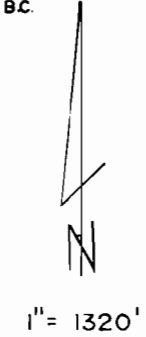
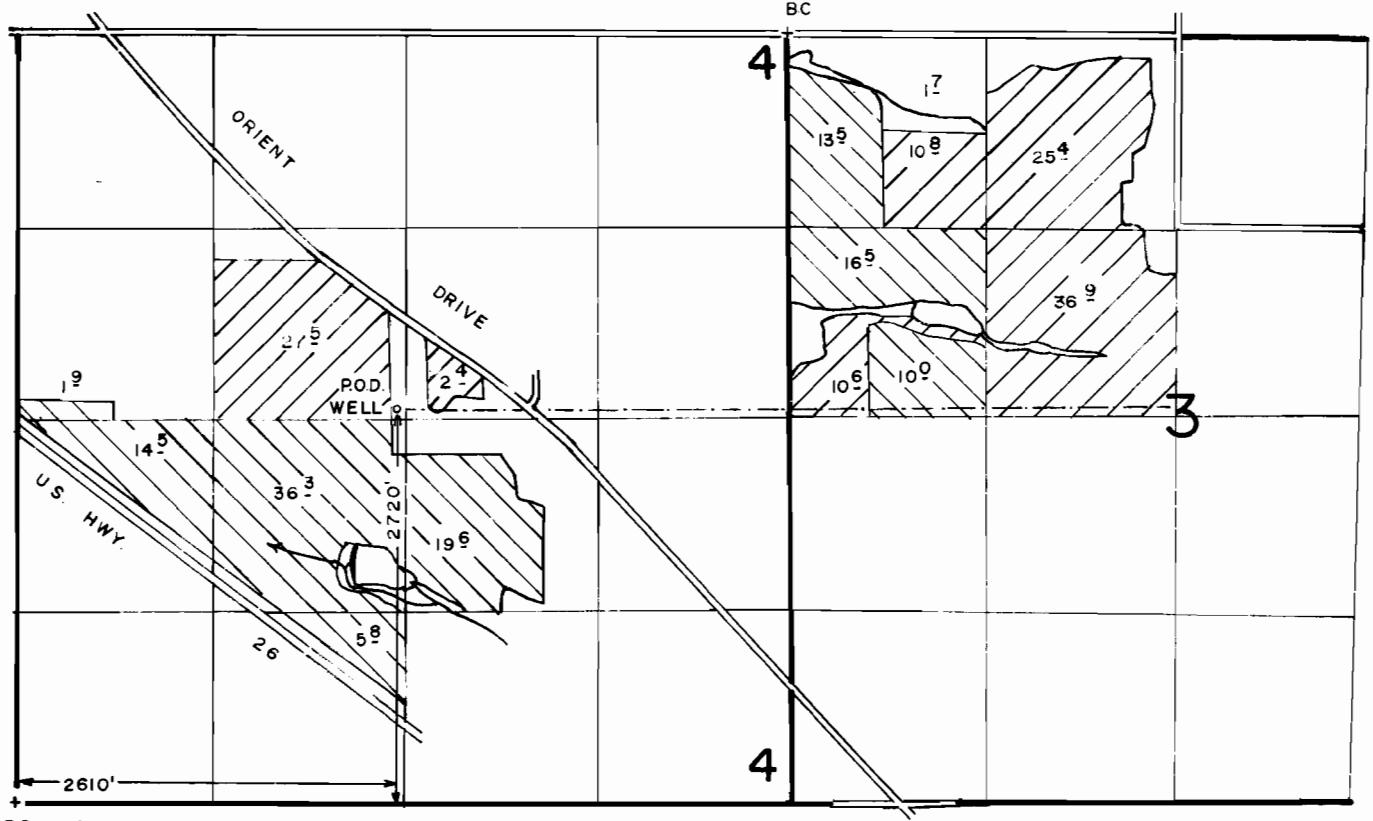

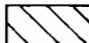



T. 2 S., R 4 E., W.M.



-  PRIMARY
-  SUPPLEMENTAL
-  OVER ACREAGE

FINAL PROOF SURVEY UNDER

Application No. G.9343 Permit No. G.8643....
IN NAME OF
J. FRANK SCHMIDT & SON CO.
 Surveyed JULY 14 1987, by T.M. WARREN...

10- 1-90 DSM
 41005-278-54A
 DFK-ILL-98