
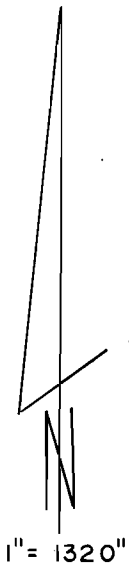


T. 2 S., R. 4 E., W. M.

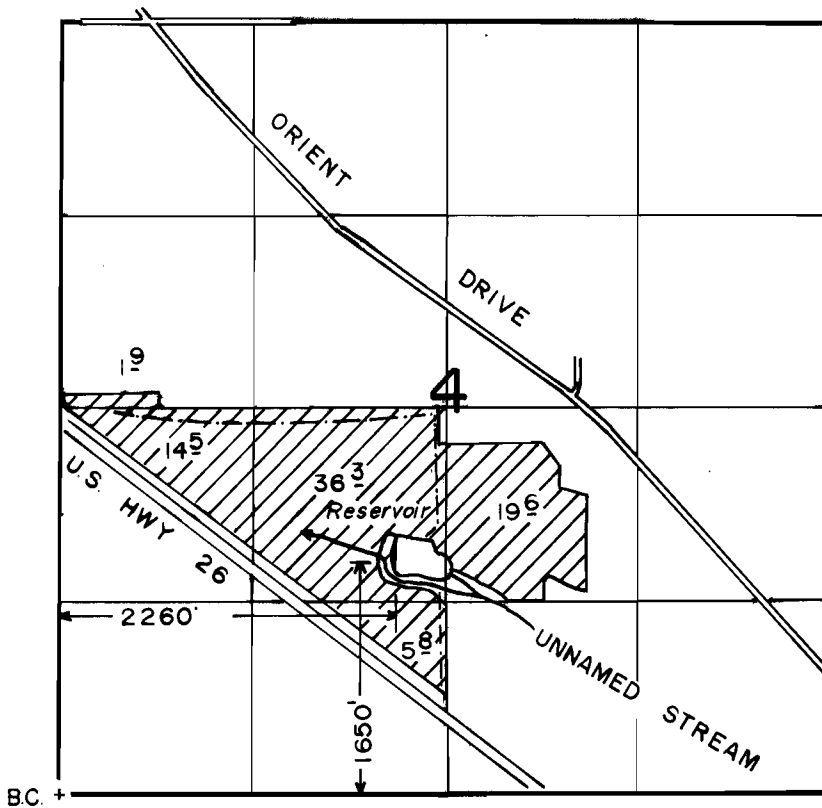

**FINAL PROOF SURVEY
UNDER**

R-56363 R-6697
Application No. 56362 Permit No. 42313
IN NAME OF

J. FRANK SCHMIDT JR.

Surveyed JULY 14 1987, by T.M. WARREN.

8-31-90 DSM
41005-278-54A