T. 38 S., R. 7 W., W. M.

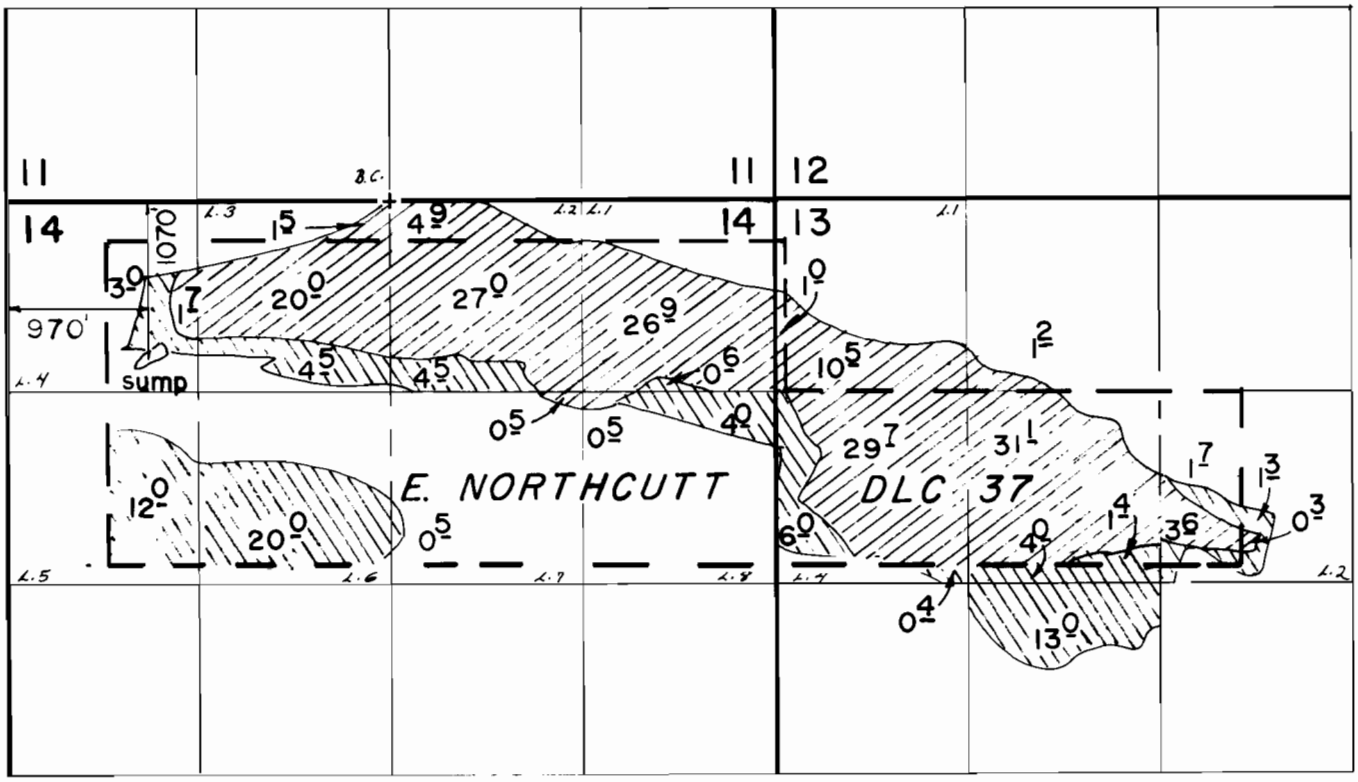

Scale: 1" = 1320'

N

Primary

Supplemental

FINAL PROOF SURVEY
UNDER

Application No. G-10083 Permit No. G-9518
IN NAME OF

JOHNNY EYGABROAD

Surveyed JUL. 24 1986, by B. S. JAMES

41033-179-173R LMJ