


T. 31 S., R. 2 W., W. M.

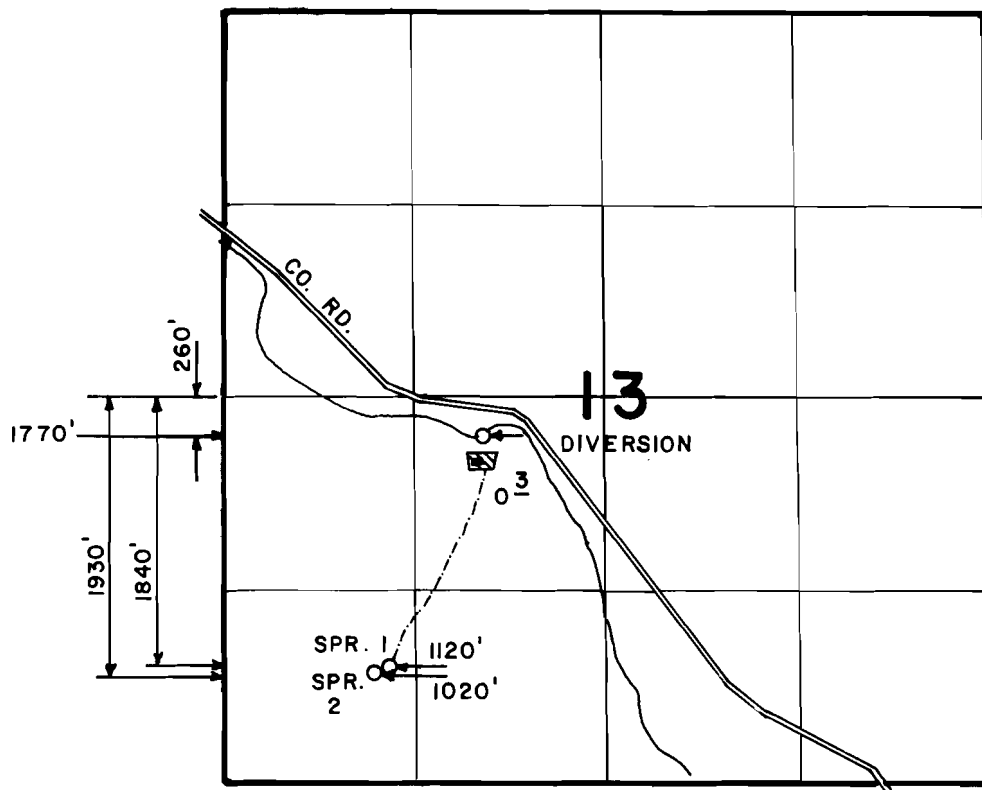

SCALE: 4" = 1 MILE

FINAL PROOF SURVEY UNDER

Application No. 53481..... Permit No. 39872.....
IN NAME OF

RAY D. & DOROTHY A. NORRIS

Surveyed APRIL 5, 1988, by J.M. SCHMORDE