


T. 8 S., R. 19 E., W.M.

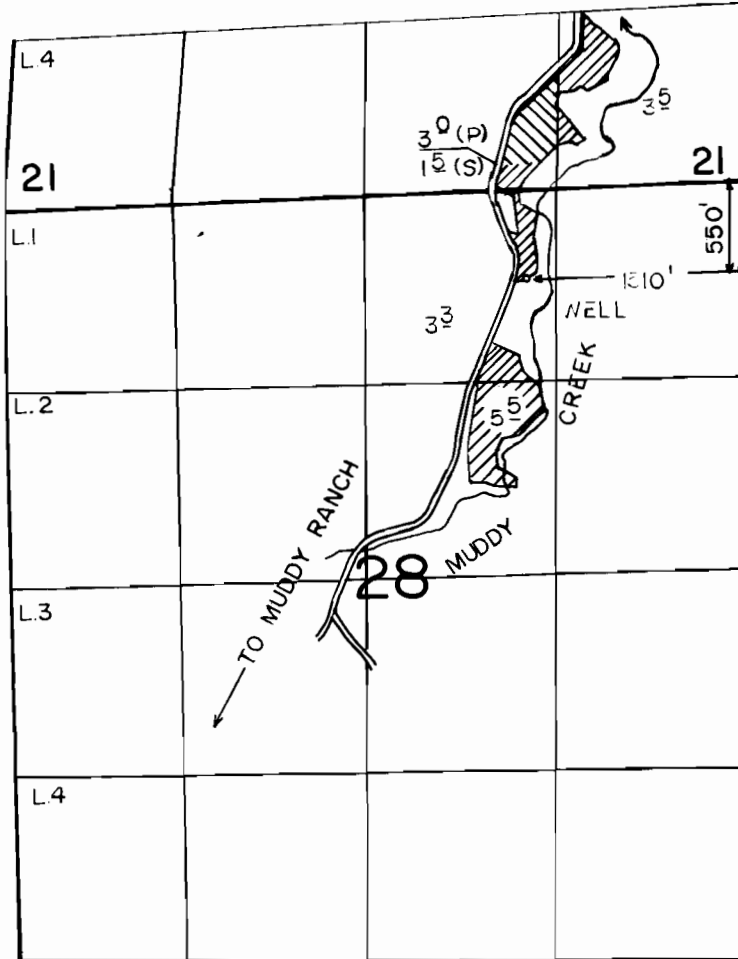

 PRIMARY
 SUPPLEMENTAL (PRIOR 1888)

FINAL PROOF SURVEY UNDER

Application No. G-10728 Permit No. G-9856
 IN NAME OF

RAJNEESH NEO-SANNYAS INTERNATIONAL COMMUNE

Surveyed AUGUST 16 1990, by B.W. BISHOP

1-24-91 DSM
 PTS 11-1990