


T.29S., R.5W., W.M.

SECTION 32

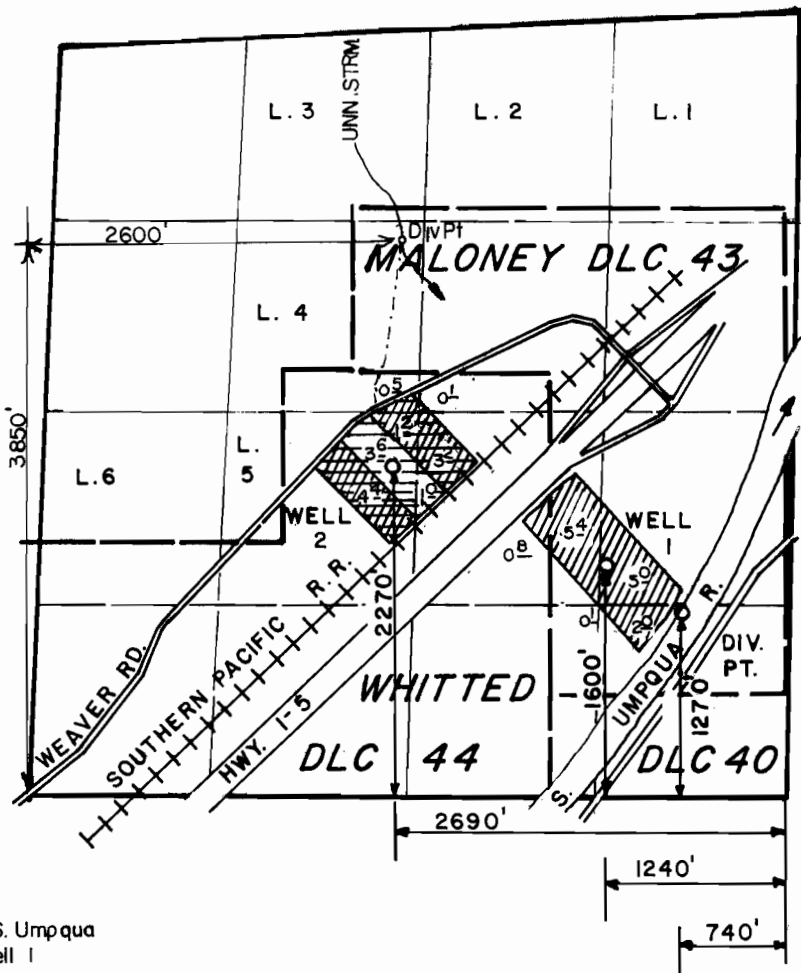

SCALE: 4" = 1 MILE

FINAL PROOF SURVEY UNDER

G-11048 G-10207
Application No. 65510 Permit No. 47771.....
IN NAME OF

ARLEN AND RICK WEAVER

Surveyed MAY 28... 1986... by J.M. SCHMORDE.