



T.19S., R.43&44E., W.M.

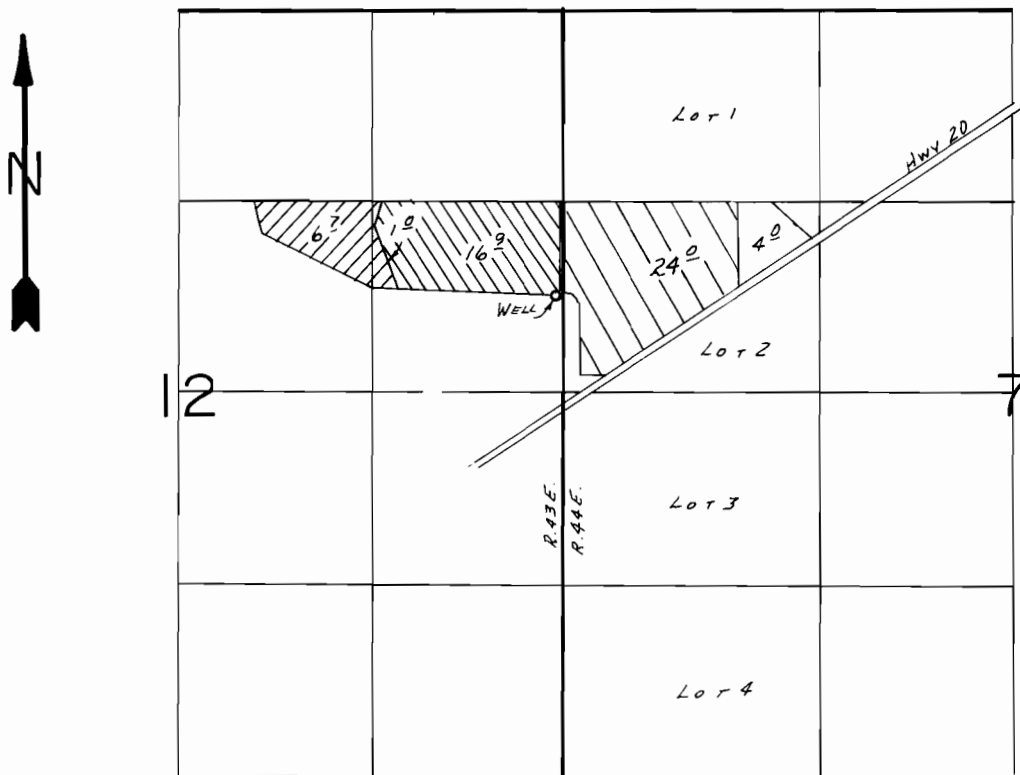

WELL LOC.: 1960'S. $\frac{1}{4}$ 50' W. FROM NE COR. SEC. 12.

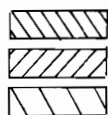

G-8736 Primary

G-8736 Supplemental

G-11090

SCALE: 1"=1320'

FINAL PROOF SURVEY UNDER

Application No. G-8736 G-8403
G-11090 Permit No. G-10302...
IN NAME OF

JACK D. PRESSLEY

Surveyed Apr. 30... 1986, by L.M. TOLL