


T. 28 S., R. 14 E., W.M.

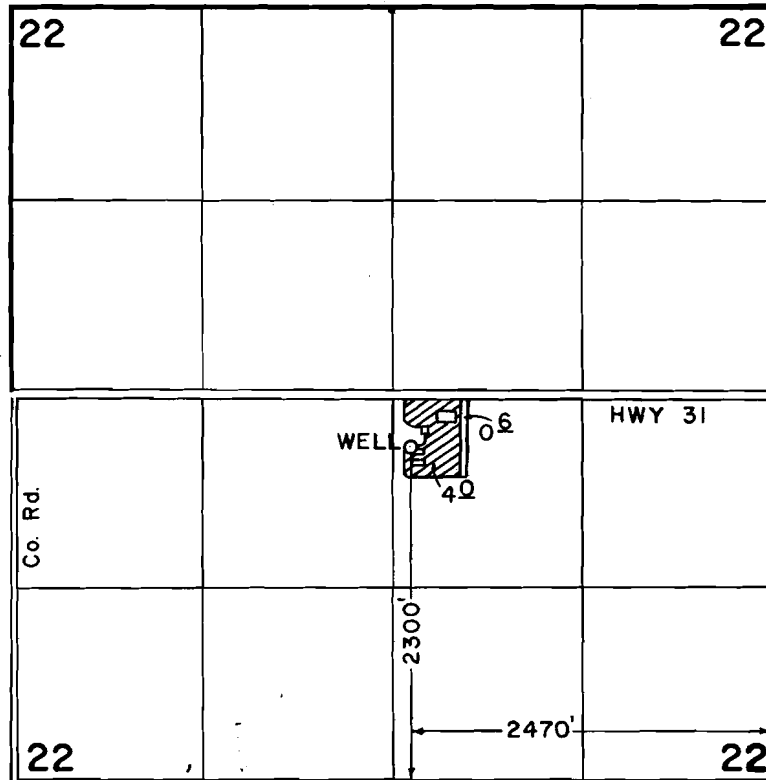

SCALE: 1" = 1320'

FINAL PROOF SURVEY UNDER

Application No. G-11159. Permit No. G-10328.
IN NAME OF

NORTH LAKE SCHOOL DIST. 14 (SILVER LAKE ELEM. SCHOOL)

Surveyed SEPT. 13, 1985, by T. WARREN.....

