


T. 6 S., R. 1 W., W. M.

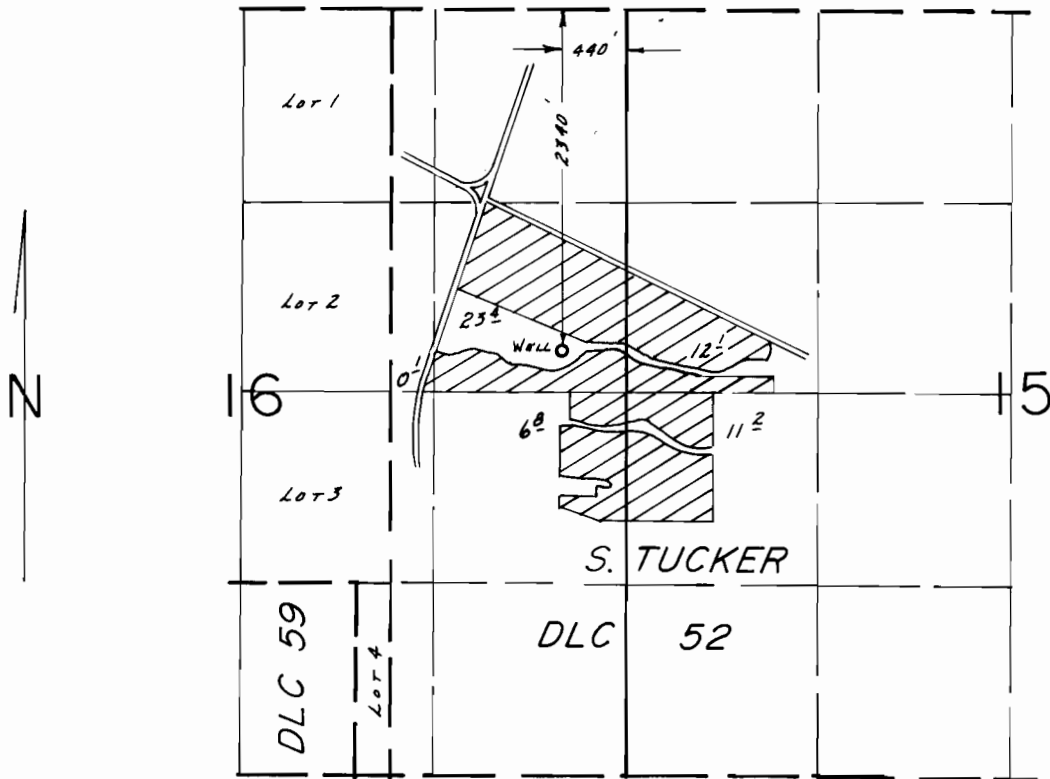

SCALE: 1" = 1320'

FINAL PROOF SURVEY UNDER

Application No. G-11547 Permit No. G-10632...
IN NAME OF

RONALD G. BUHR

Surveyed May 18, 1988, by Z. SALEH

3/2/89
BWB