


6-10640
66479

T.3N., R.34E., W.M.

RECEIVED

JUL 25 1986

WATER RESOURCES DEPT
SALEM, OREGON

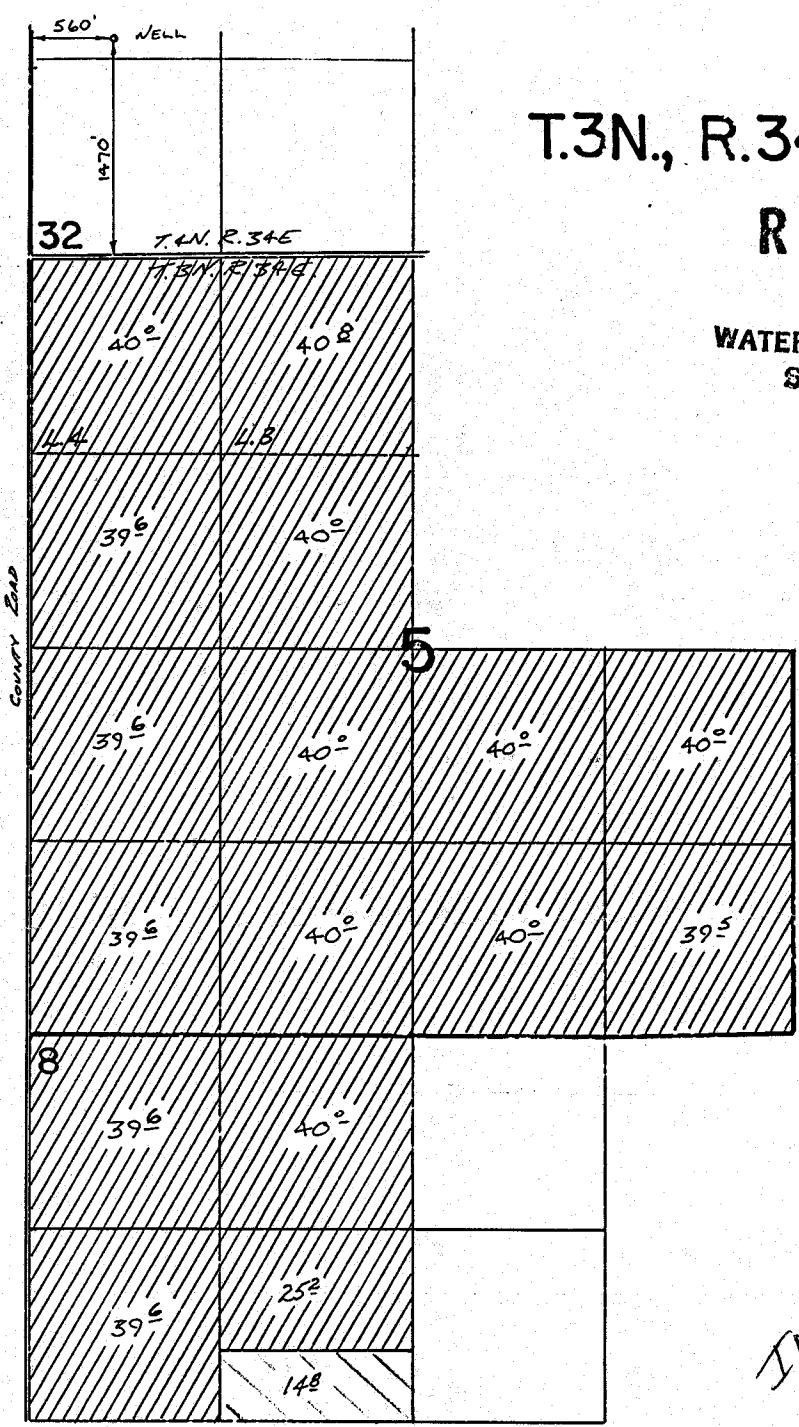

INSPECTED

~~FINAL PROOF SURVEY~~

UNDER

~~Application No. G-7991 Permit No. G-7413~~

IN NAME OF

BARNETT RUGG, INC.

Surveyed ~~Nov 12~~ 1991 by H. L. Church

Application No. D-11562
Permit No. G10640