






T. 40 S., R. 41 E., W.M.

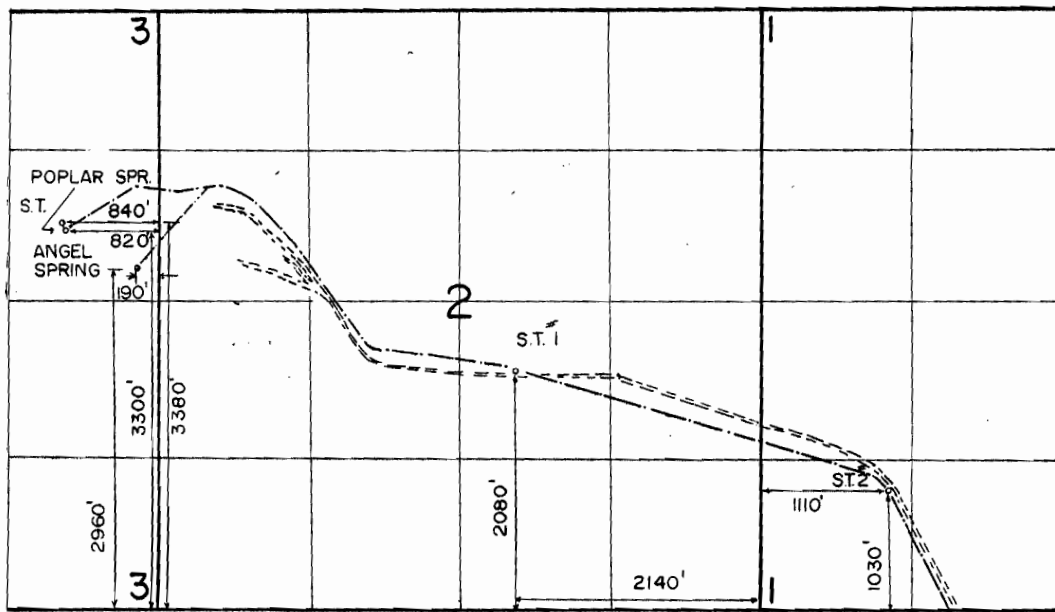


T. 40 S., R. 41 E., W.M.

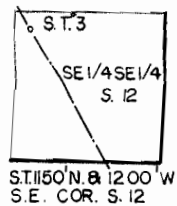


T. 40 S., R. 42 E., W.M.

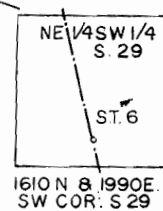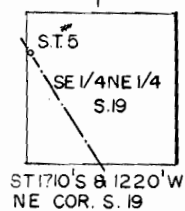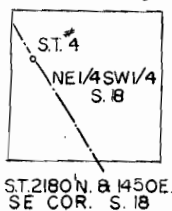


T. 40 S., R. 42 E., W.M.

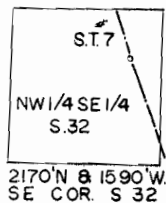

T. 41 S., R. 42 E., W.M.

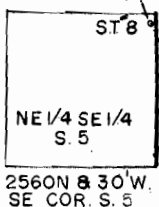

T. 41 S., R. 42 E., W.M.

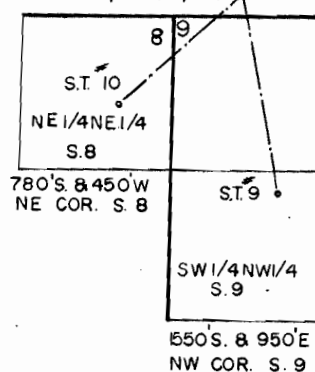

FINAL PROOF SURVEY

APPLICATION 41791
40926

PERMIT 31285
30535

BUREAU OF LAND MANAGEMENT