

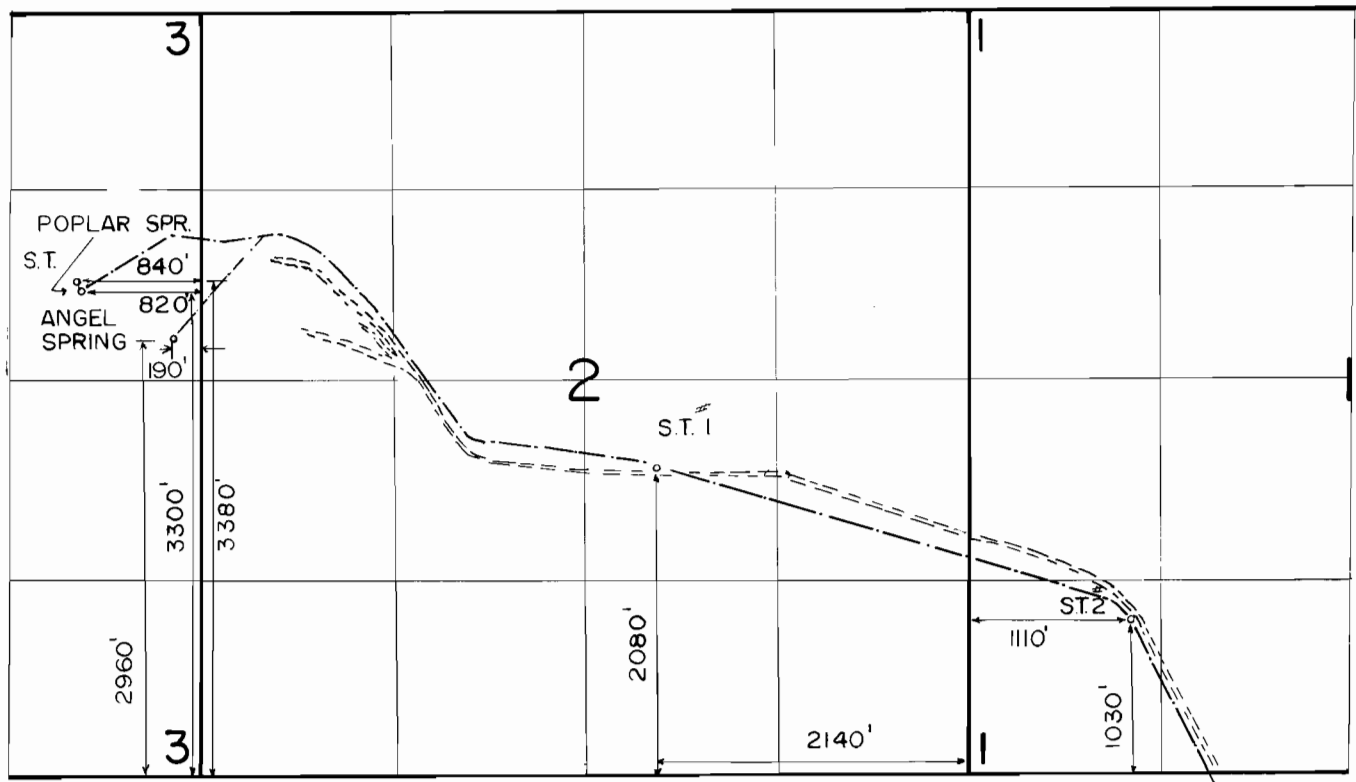





T. 40 S., R. 41 E., W.M.

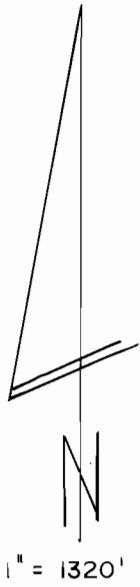


T. 40 S., R. 41 E., W.M.

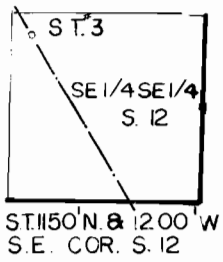


T. 40 S., R. 42 E., W.M.

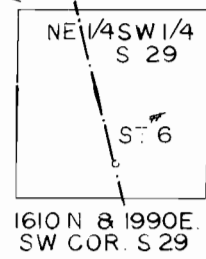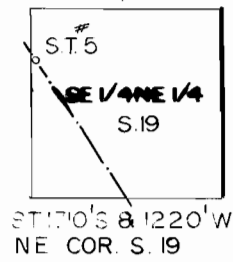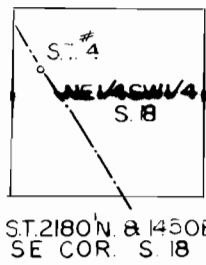


T. 40 S., R. 42 E., W.M.

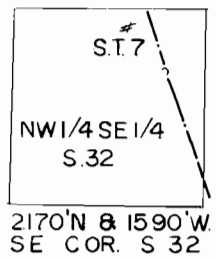

T. 41 S., R. 42 E., W.M.

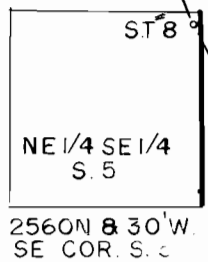

T. 41 S., R. 42 E., W.M.

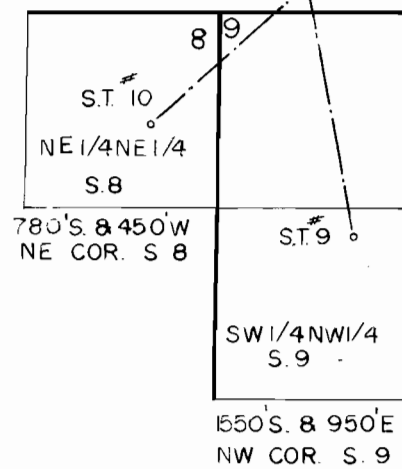

FINAL PROOF SURVEY

APPLICATION 41791
40926

PERMIT 31285
30535

BUREAU OF LAND MANAGEMENT

SURVEYED JUNE 17, 1976 BY L.E. GOULD
JULY 18, 1985 L. TOLL

2-13-91
41045-178-251 L
41045-178-25LR
PTS. 1976 L
QUAD: BOGHOLE SPRING