


# T.1 & 2 N., R.4 & 5 W., W.M.

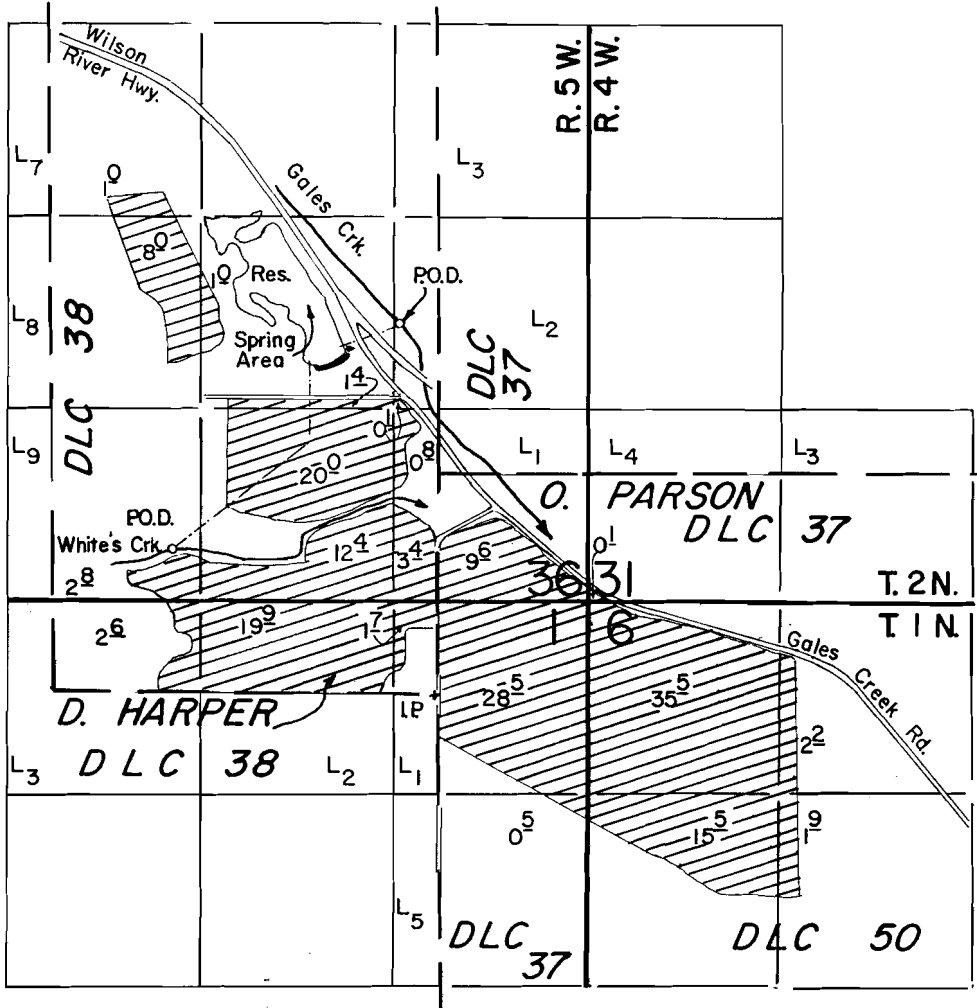

Spring Area Loc. : 2650' N. & 900' W.  
 White's Crk. P.O.D. Loc. : 970' N. & 1800' W.  
 Gales Crk. P.O.D. Loc. : 2540' N. & 260' W., all from SE Cor. DLC 38.

Scale : 1" = 1320'  
**FINAL PROOF SURVEY**  
 UNDER

R-49390                      R-7596  
 Application No. 49391    Permit No. 43206  
 IN NAME OF

**JOHN D. PETSHOW**

Surveyed March 31 1988, by T. Warren.....