


T.1 & 2 N., R.4 & 5 W., W.M.

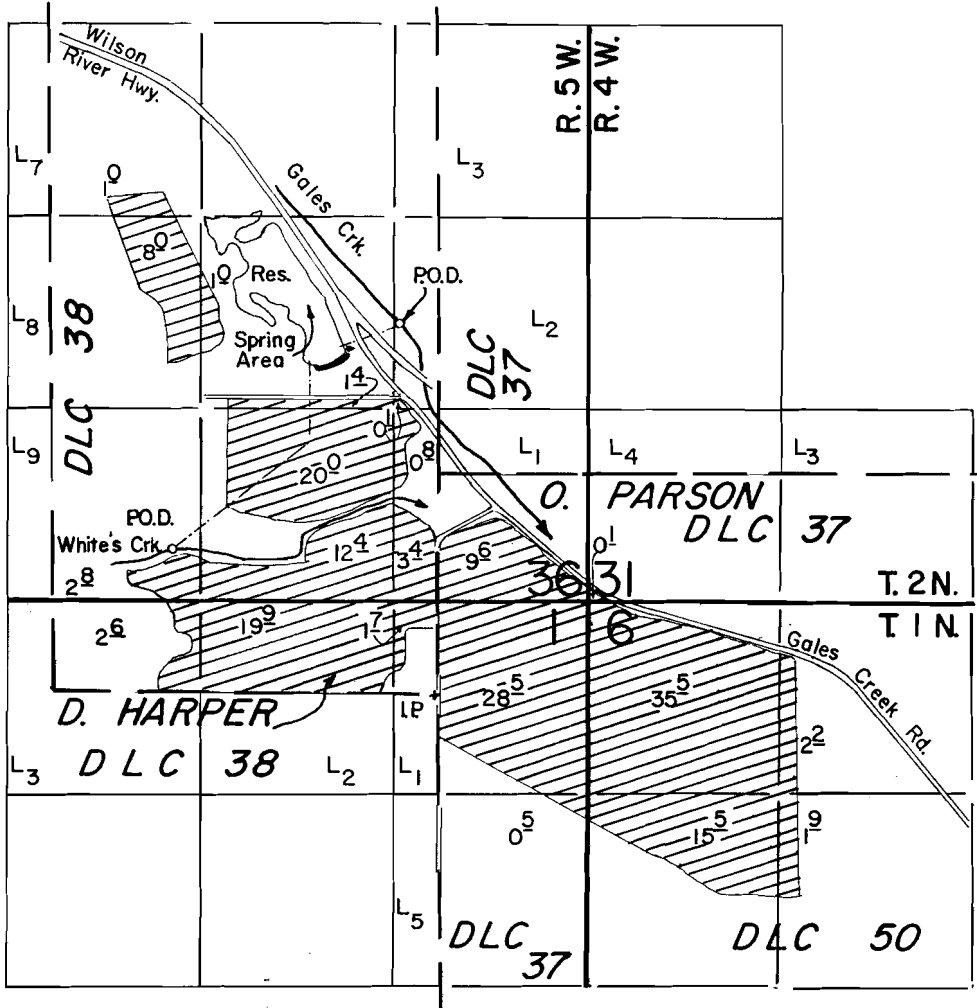

Spring Area Loc. : 2650' N. & 900' W.
 White's Crk. P.O.D. Loc. : 970' N. & 1800' W.
 Gales Crk. P.O.D. Loc. : 2540' N. & 260' W., all from SE Cor. DLC 38.

Scale : 1" = 1320'
FINAL PROOF SURVEY
 UNDER

R-49390 R-7596
 Application No. 49391 Permit No. 43206
 IN NAME OF

JOHN D. PETSHOW

Surveyed March 31 1988, by T. Warren