




# T.7S., R.3W., W.M.

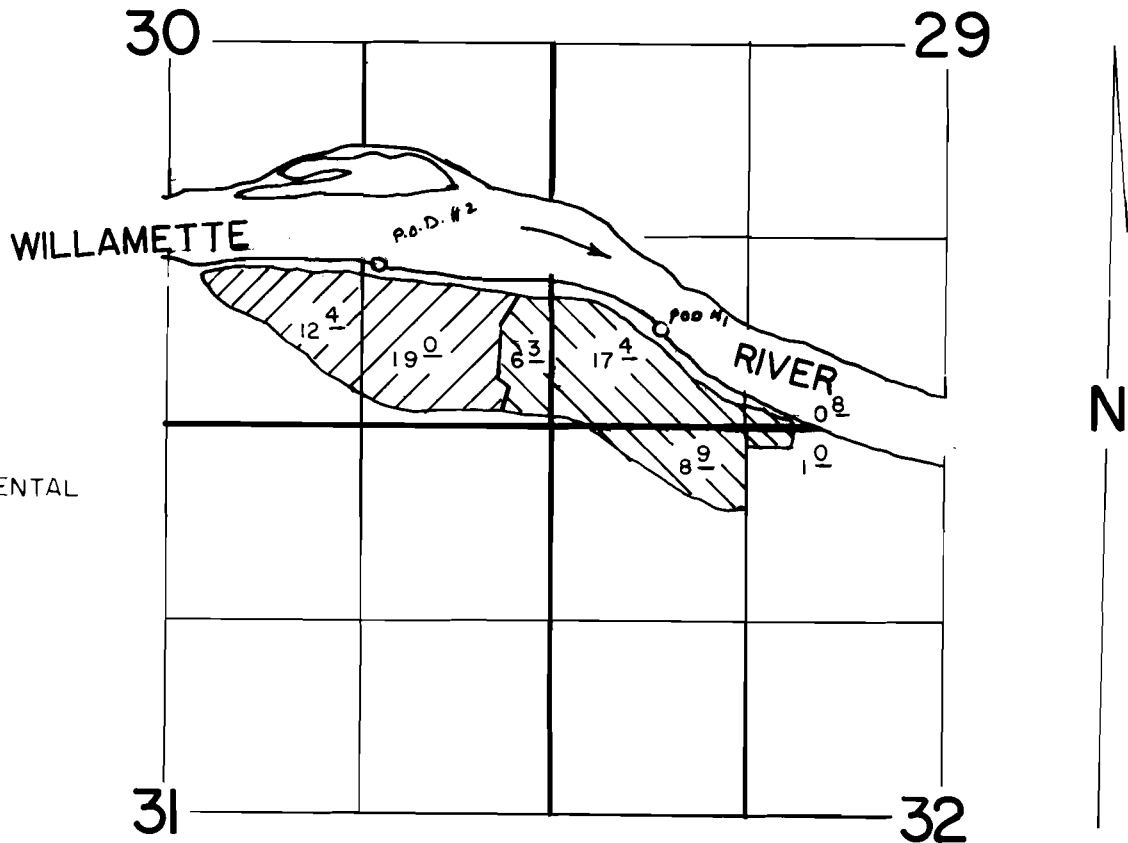

-  SUPPLEMENTAL
-  PRIMARY

P.O.D.#1 : 720' E AND 660' N ; P.O.D.#2 : 1100' N AND 1290' W ALL FROM SE CORNER SECTION 30.

SCALE 1" = 1320'  
**FINAL PROOF SURVEY**  
 UNDER

Application No. **55495** Permit No. **41836**  
 IN NAME OF

**ROBERT D. TRUSSELL**

Surveyed **JUN 30 1988**, by **Z. SALEH**