


T 18 S R 1 W W M

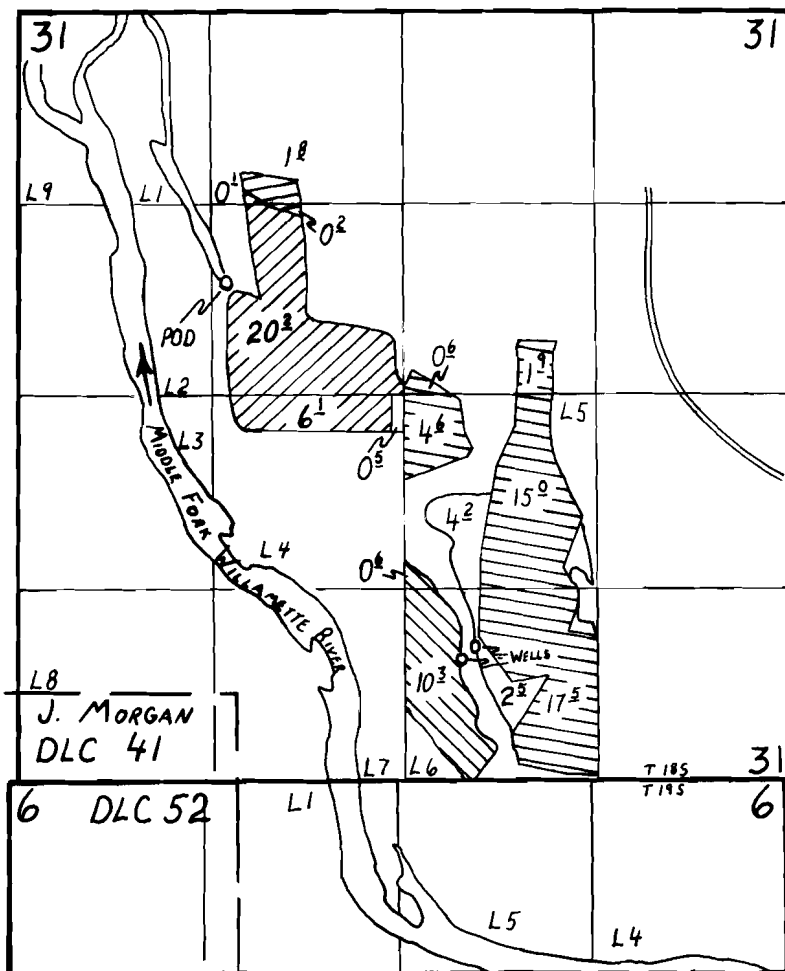

1" = 1320'

POD IS LOCATED 770' N AND 1200' W; THE WELL FOR PERMIT G-7797 IS LOCATED 1800' S AND 400' E; THE WELL FOR PERMIT G-2414 IS LOCATED 1720' S AND 480' E; ALL BEING LOCATED FROM THE CENTER 1/4 OF SECTION 31

- | | | | | |
|---|---|---|---|---|
|  |  |  |  |  |
| IRR. UNDER PERMIT G-2414 AND SUPP. IRR. UNDER PERMIT 48427 | IRR. UNDER PERMIT G-7797 | SUPP. IRR. TO PERMIT 26502 UNDER PERMIT 48427 | IRR. UNDER PERMIT 48427 | OVER ALCREAGE IRR. |

FINAL PROOF SURVEY UNDER

Application No. ~~55574~~ ^{G-2579} ^{G-7963} Permit No. ~~48427~~ ^{G-2414} ^{G-7797}.....
IN NAME OF

GARY A. SANDGATHE
.....
MAY 5 66 V. GARNER
AUG 3 82 L. M. TOLL
Surveyed Aug. 8, 1990., by T. M. WARREN.....

PTS 1966A PERMIT G-2414
DBQ 431 46 PERMIT G-7797 RWK
4039 378 64R PERMIT 48427 1/8/91