


T 20S R 2W WM

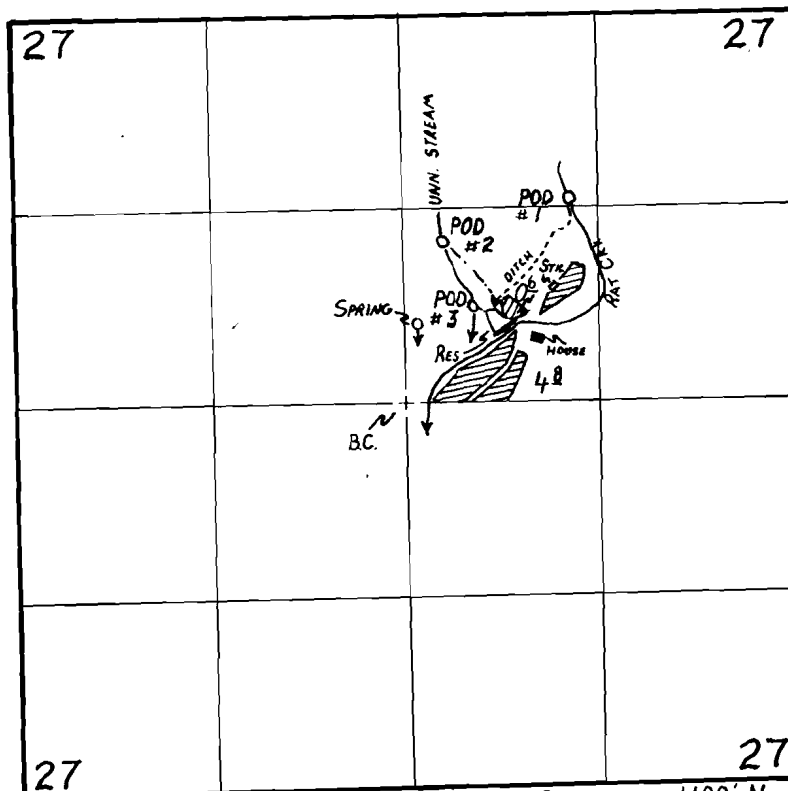

1" = 1320'

POD #1 IS LOCATED 1400' N AND 1150' E; POD #2 IS LOCATED 1100' N AND 290' E; POD #3 IS LOCATED 650' N AND 500' E; SPRING IS LOCATED 530' N AND 100' E, ALL BEING LOCATED FROM THE CENTER 1/4 SECTION 27



FINAL PROOF SURVEY UNDER

R-56472 R-6653
Application No. 56473 Permit No. 41994
IN NAME OF

..... ELTON L. HALE

Surveyed Aug. 22.. 19.90., by T.M. WARREN.....