


T. 30S., R. 4W., W.M.

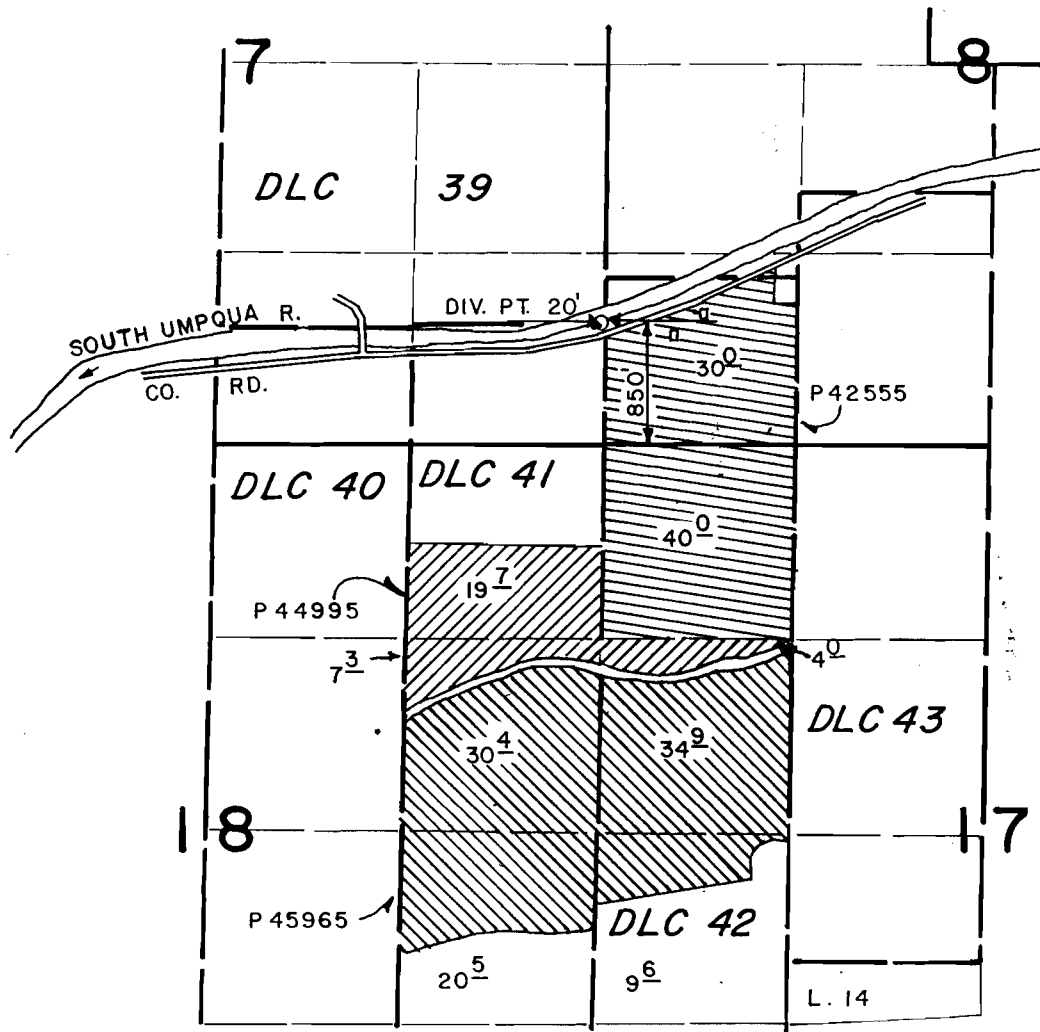

SCALE: 4" = 1 MILE

FINAL PROOF SURVEY
UNDER

61672 45965
59876 44995
Application No. 56597... Permit No. 42555

IN NAME OF

HAYDEN L. & ROI JEAN LAURANCE

Surveyed JUNE 24 1986, by J. M. SCHMORDE