




T.39S., R.2 W., W.M.

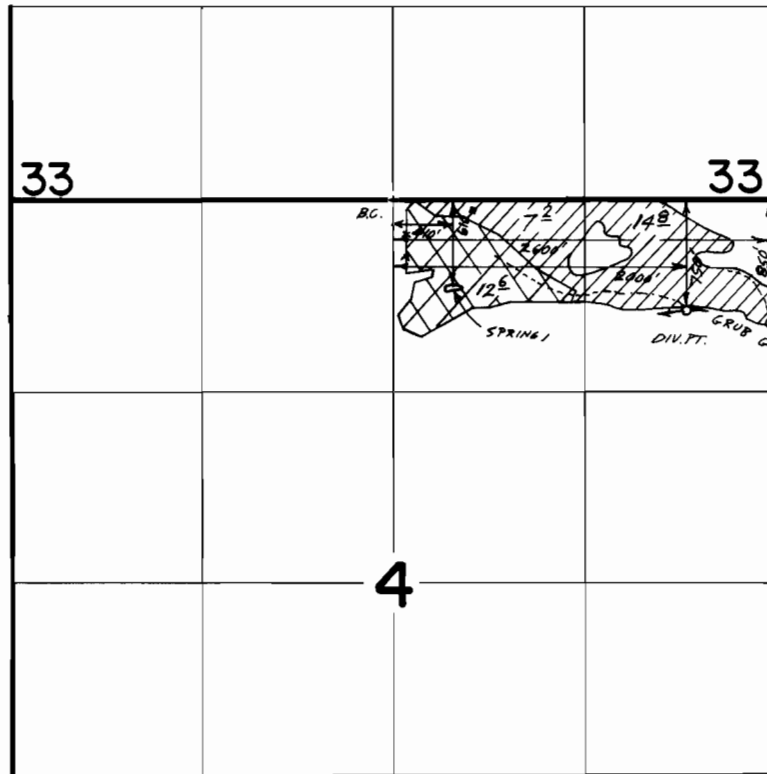

Scale 1"=1320'



-  PRIMARY
-  SUPPLEMENTAL

FINAL PROOF SURVEY
UNDER

Application No. 57211 Permit No. 43013

IN NAME OF
JOHN F. GILLILAND
SHEILA FERSON JENKINS

Surveyed JULY 9, 1986, by B.S. JAMES