


T. 29 S., R. 4 W., W. M.

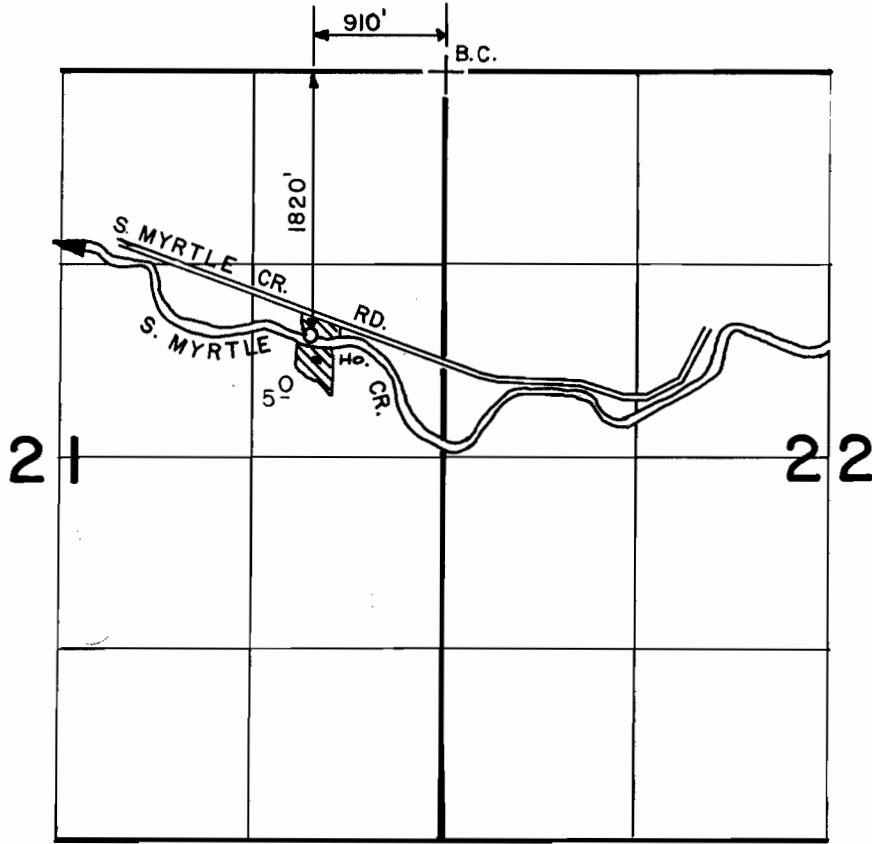

SCALE: 4" = 1 MILE

FINAL PROOF SURVEY
UNDER

Application No. 59242... Permit No. 44546
IN NAME OF

THEODORE S. HOLDER

Surveyed JUNE 3, 1986, by J. M. SCHMORDE