


T.30S., R.3 W., W. M.

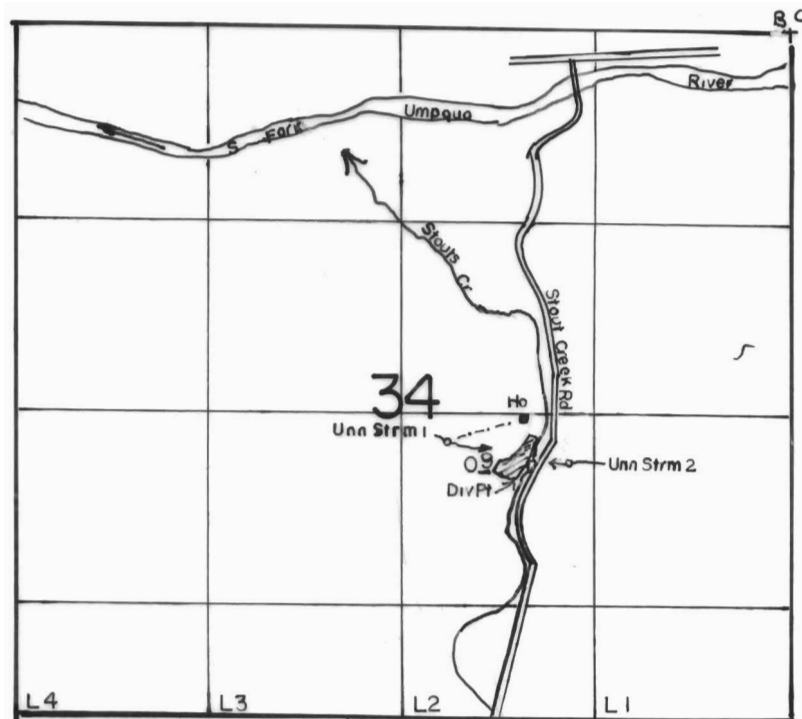

Div Pts Located, Creek-1720'N&1750'W, Stream 1-1900'N&2350'W, Stream 2
1750'N&1500'W, All From The SE Corner Of Section 34

SCALE: 1"=1320'

FINAL PROOF SURVEY UNDER

Application No. 59556. Permit No. 44843.....
IN NAME OF

.....HADI & SANDRA.....BITAR.....

Surveyed MARCH 27 1990., by B.S. JAMES.....