


T. 32 S., R. 4 W., W. M.

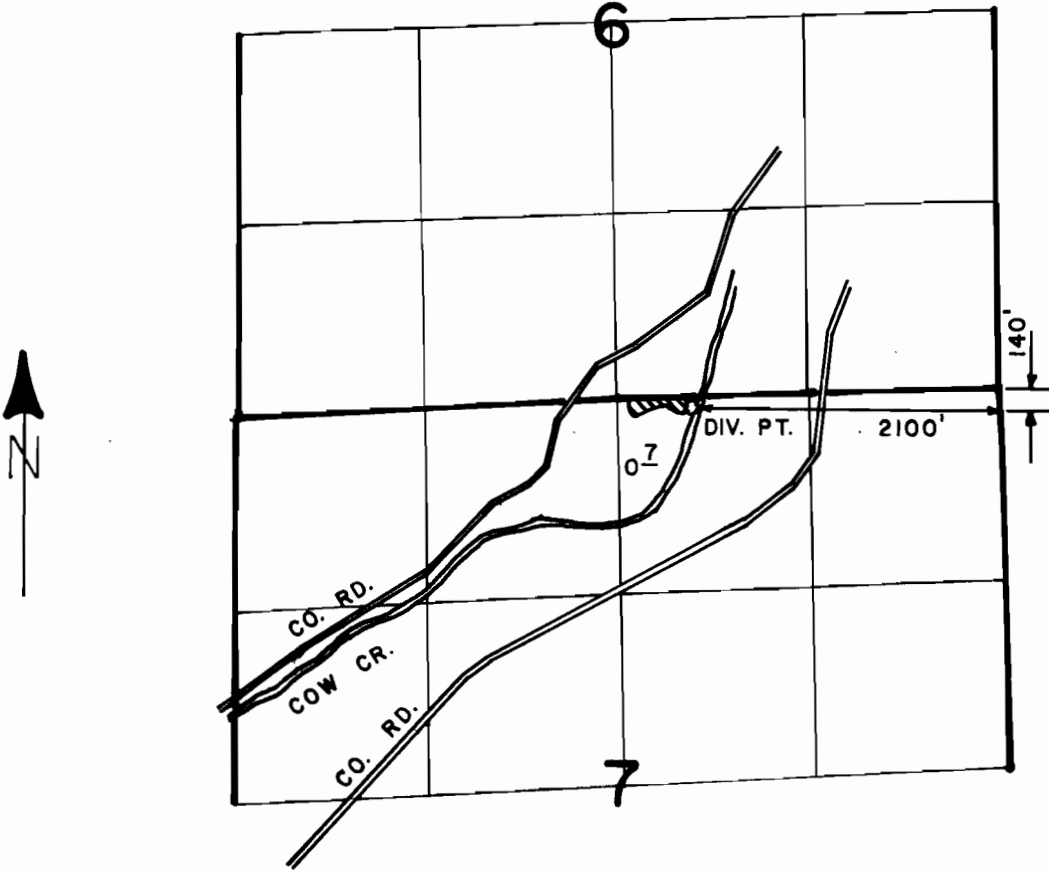

FINAL PROOF SURVEY
UNDER

Application No. 60470. Permit No. 45259.....
IN NAME OF

.....**WALTER J. DOLL**.....

Surveyed JULY 6... 1988, by J. M. SCHMORDE