


# T. 33 S., R. 7 1/2 E., W.M.

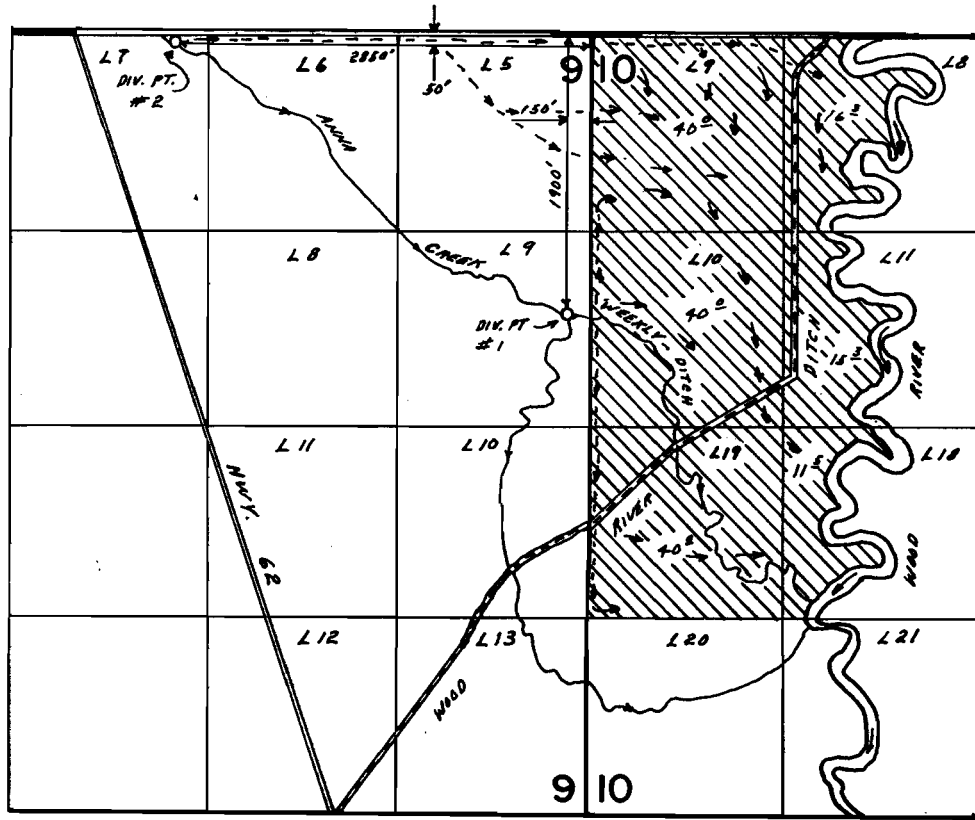

SCALE: 1"=1320'

## FINAL PROOF SURVEY UNDER

Application No. 63479 Permit No. 46991  
IN NAME OF

R. L. HUNSAKER

Surveyed AUG. 20 19.87, by M. SCHMORDE

Anna Creek & Msc.

