



P-48221
66501

T. 9 S. R. 25 E. W. M.

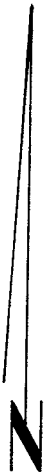

SCALE: 1"=1320'

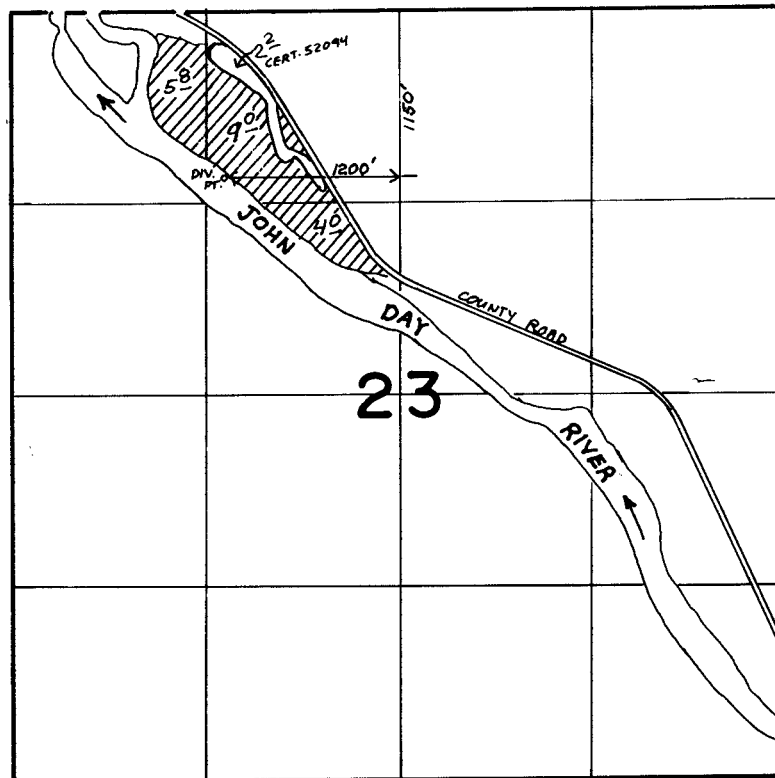

FINAL PROOF SURVEY

UNDER

Application No. 67901 Permit No. 48221

IN NAME OF

LELAND E. & MARY E. FRYESurveyed APRIL 9 1985, by V.L. CHURCHDOV-44-176
DOV-94-138

JS