

T. 27 S., R. 13 W., W. M.



FINAL PROOF SURVEY

In the name of Phillip Parrish

Application No. 69616 Permit No. 50431

Surveyed March 6, 1989 by Forrest J. Hales

Scale 1" = 200ft.

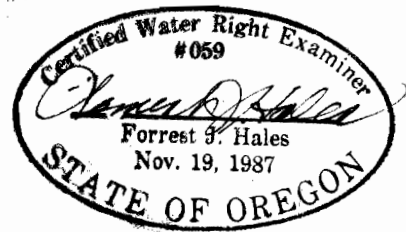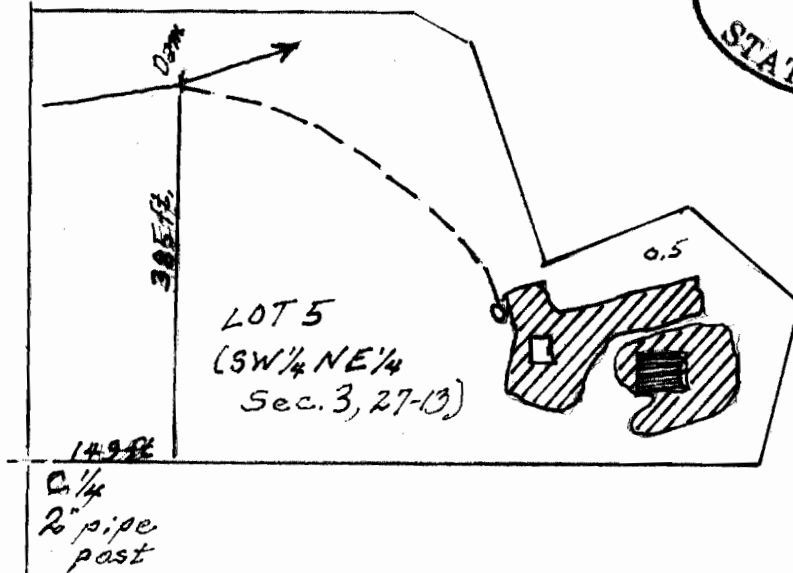

F. J. Hales 6-14-91