
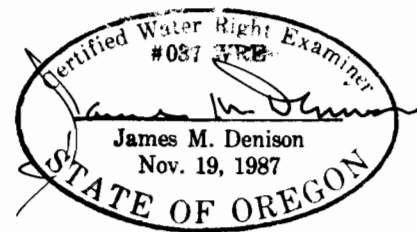
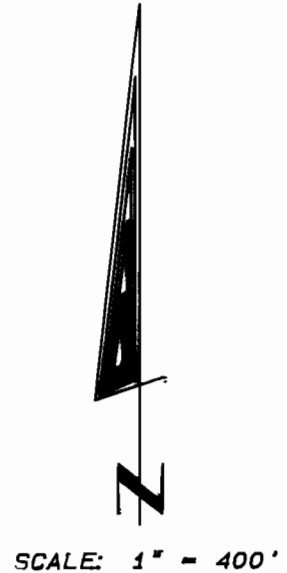


T. 10 S., R. 11 W., W.M.

SW 1/4 of Section 36
LINCOLN COUNTY, OREGON

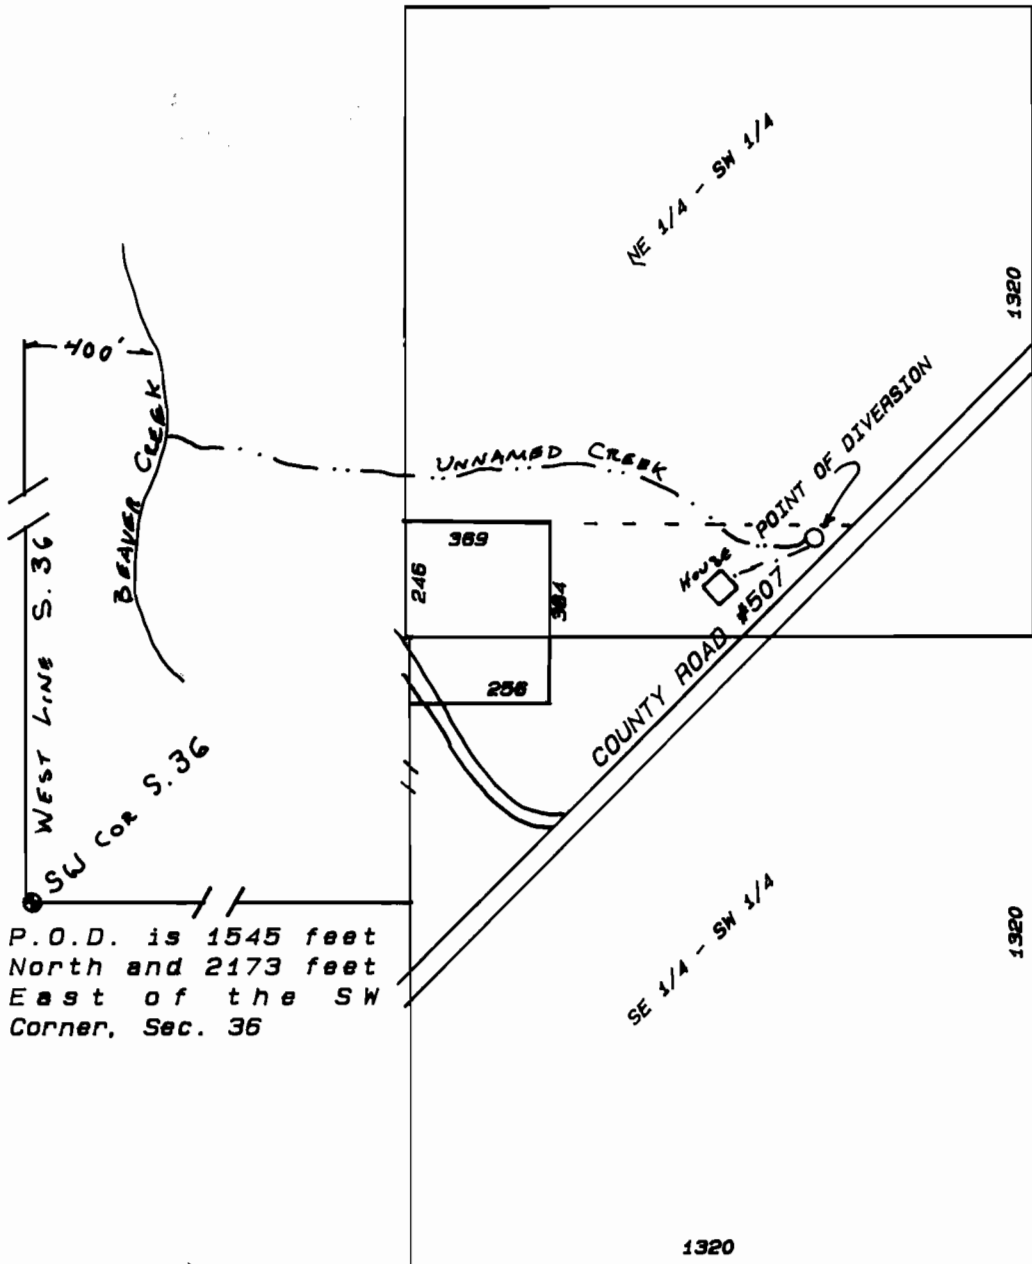

FINAL PROOF SURVEY UNDER

Application No. 69622, Permit No. 50643
IN NAME OF

Jimmie L. Horner

Surveyed April 9, 1990 by James M. Denison

This map is prepared solely for the purpose of showing location of a water right, and is not intended for use to provide dimensions or location of property ownership lines.