


FINAL PROOF MAP

T.39S. R.22E. W.M.

Verle Emery

Application # 69789

Permit # 50690

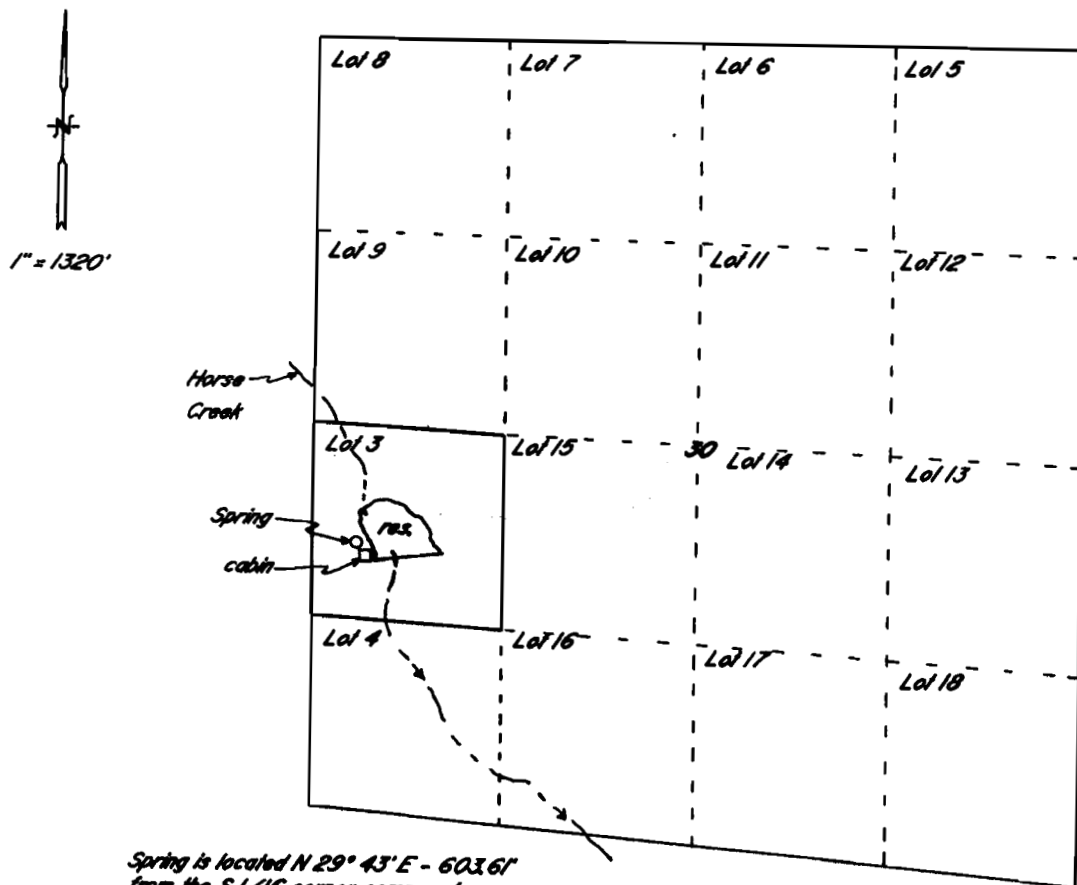

Spring is located N 29° 43' E - 603.61'
from the S 1/16 corner common to
Sections 25 & 30

09 121
PLACES
EM. OREGON

50690
66506

Revised 5/23/91

JLS

This map is for the purpose of identifying the location of the water right only
and is not intended to provide legal dimensions or location of property
ownership lines.

Permit # 50690