


copy from
57018 - 8509

T.23S., R.33&34E., W.M.

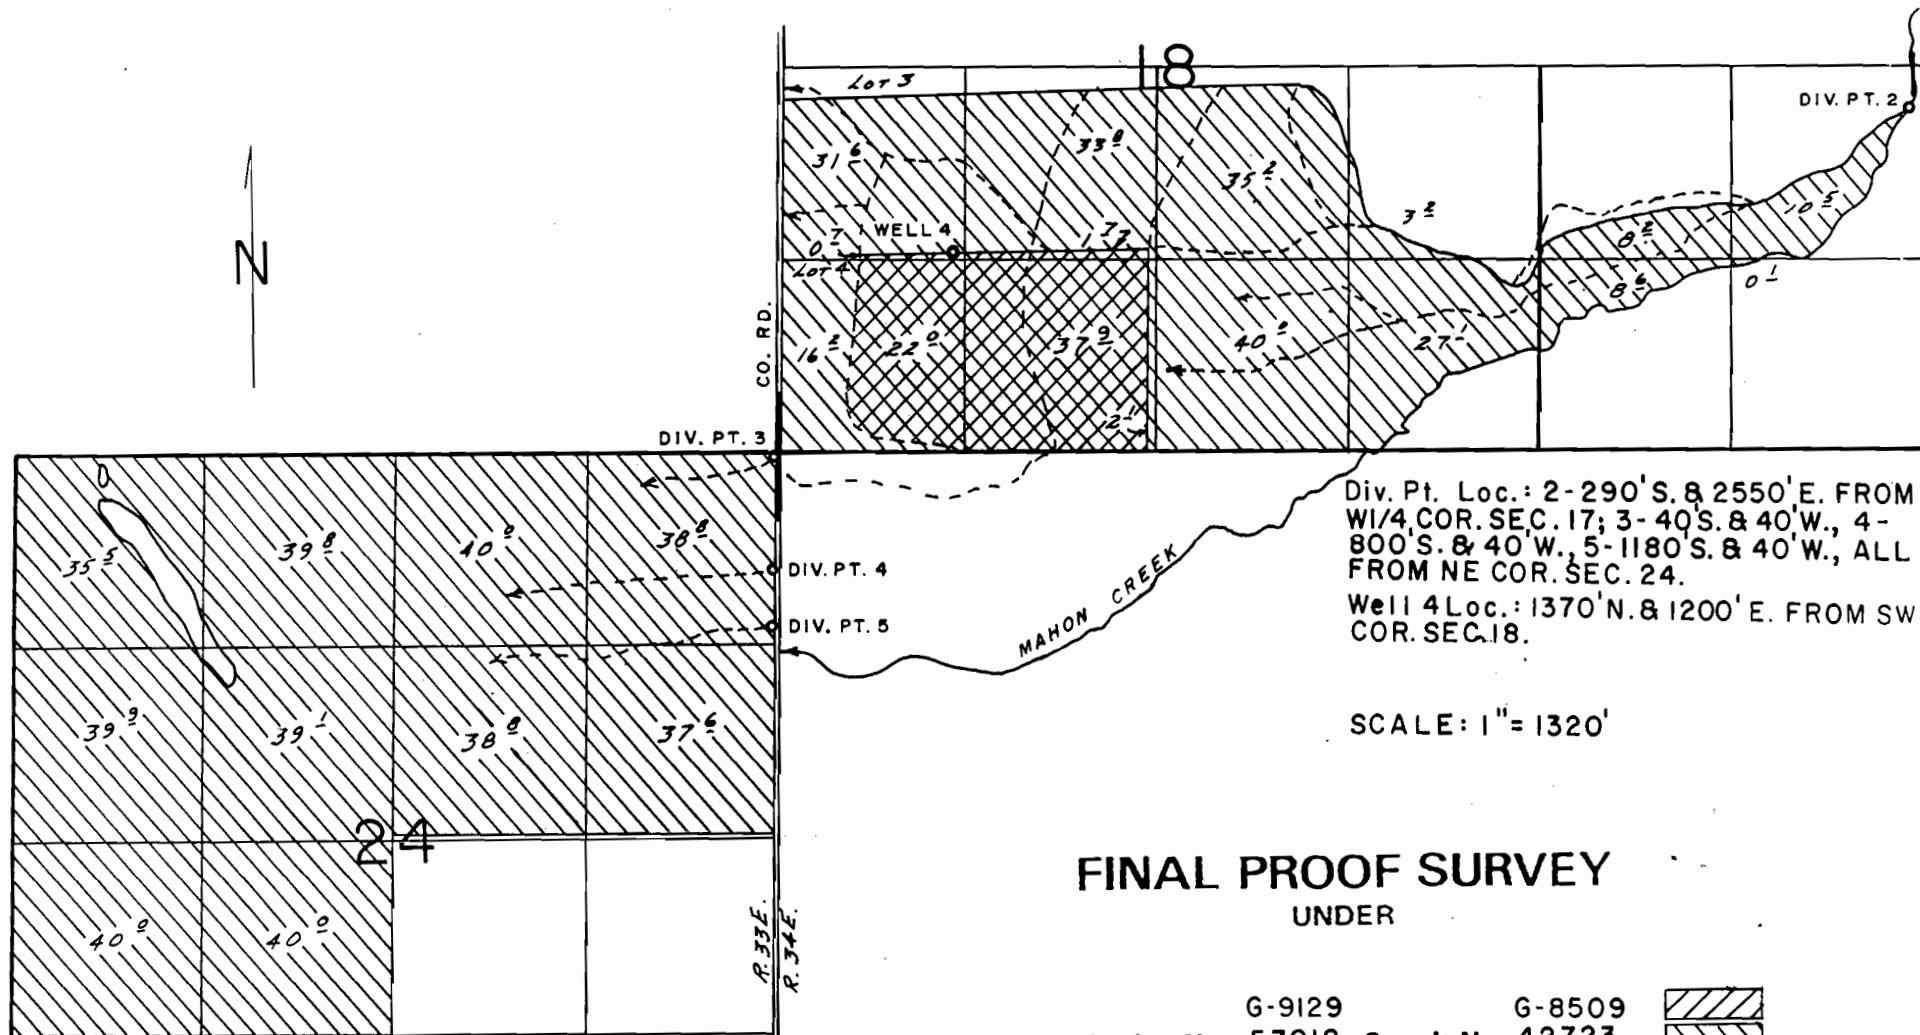

Div. Pt. Loc.: 2-290'S. & 2550'E. FROM
W1/4 COR. SEC. 17; 3-40'S. & 40'W., 4-
800'S. & 40'W., 5-1180'S. & 40'W., ALL
FROM NE COR. SEC. 24.
Well 4 Loc.: 1370'N. & 1200'E. FROM SW
COR. SEC. 18.

SCALE: 1" = 1320'

FINAL PROOF SURVEY UNDER

G-9129 G-8509
Application No. 57018... Permit No. 42723...
IN NAME OF

JOE R. & DAVID W. ARNOLD

Surveyed MAY 16... 1988, by Z. E. SALEH