


T. 23 S., R. 33 E., W.M.

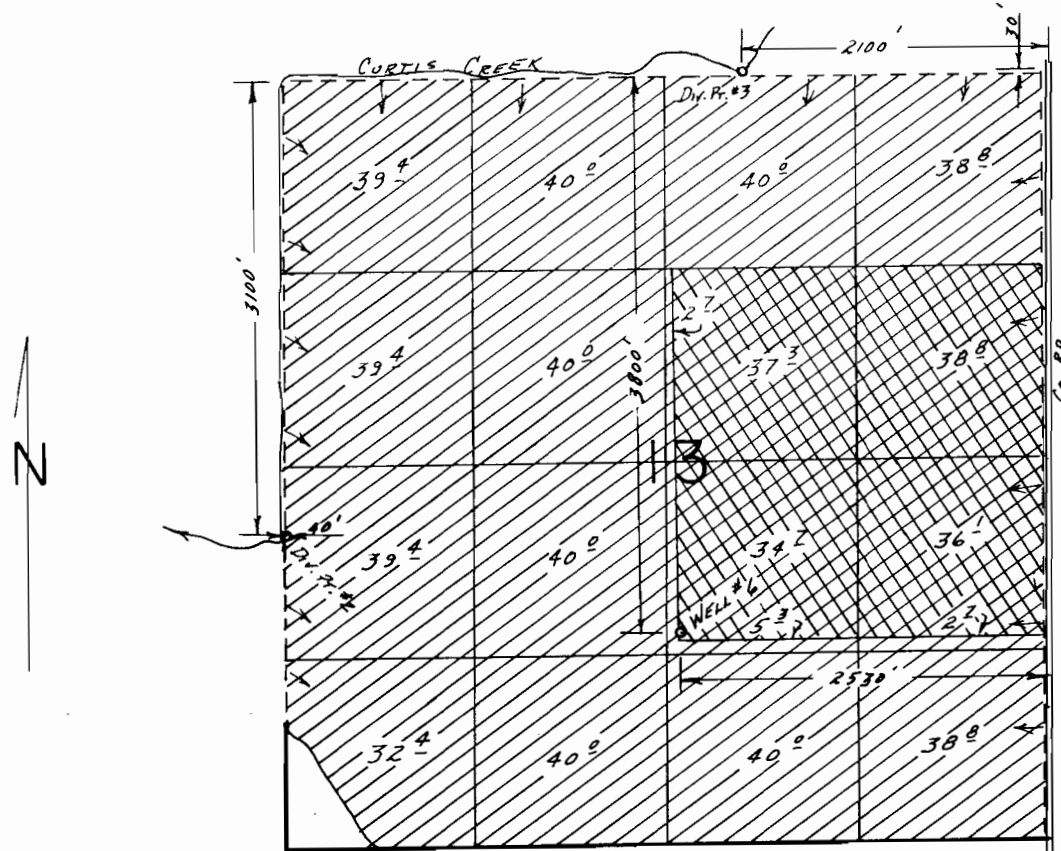

Permit 42873  
Permit G-8510

SCALE: 1" = 1320'

## FINAL PROOF SURVEY UNDER

G-9130 G-8510  
Application No. 56990 Permit No. 42873  
IN NAME OF

DAVID & JOE R. ARNOLD

Surveyed May 16, 1988, by Z. F. SALEH

5/1/89 RAB

41025-179-376