


T. 23 S., R. 33 E., W.M.

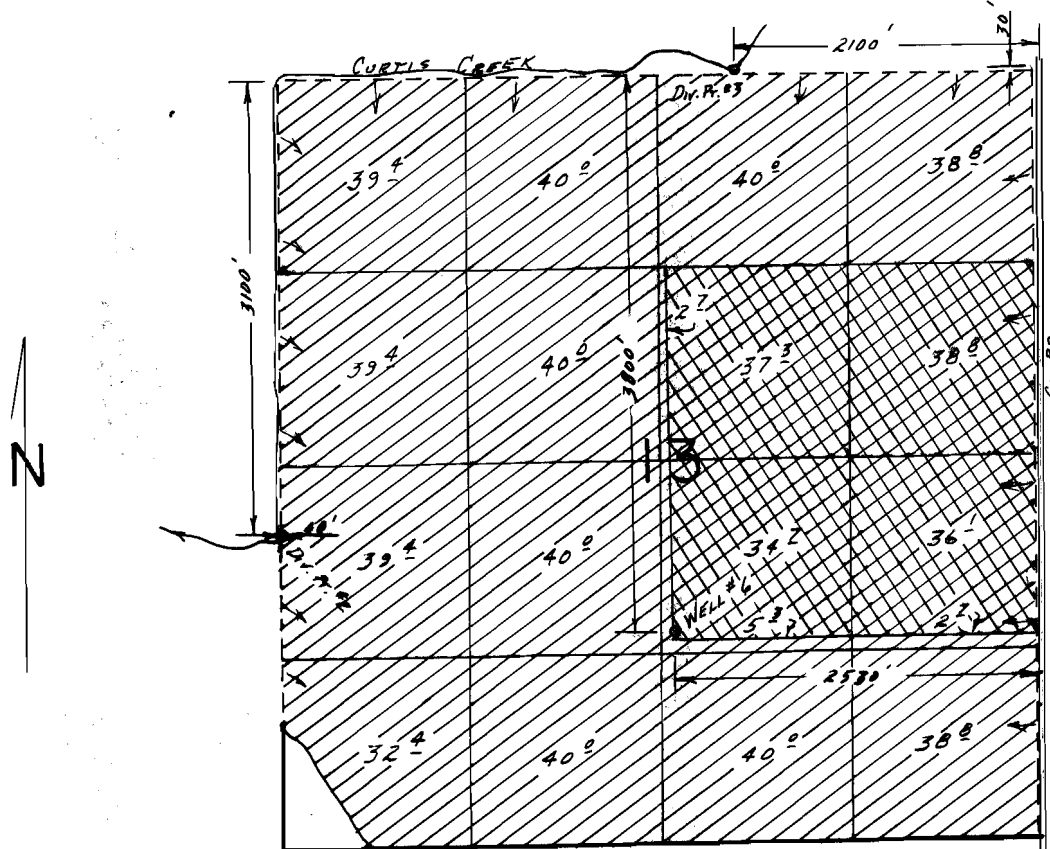

Permit 42873
Permit G-8510

SCALE: 1" = 1320'

FINAL PROOF SURVEY UNDER

G-9130 G-8510
Application No. 56990. Permit No. 42873.....
IN NAME OF

DAVID & JOE R. ARNOLD.....

Surveyed May 16, 1988, by Z. F. SALEH.....