


copy from
57018 - 8509

T.23S., R.33&34E., W.M.

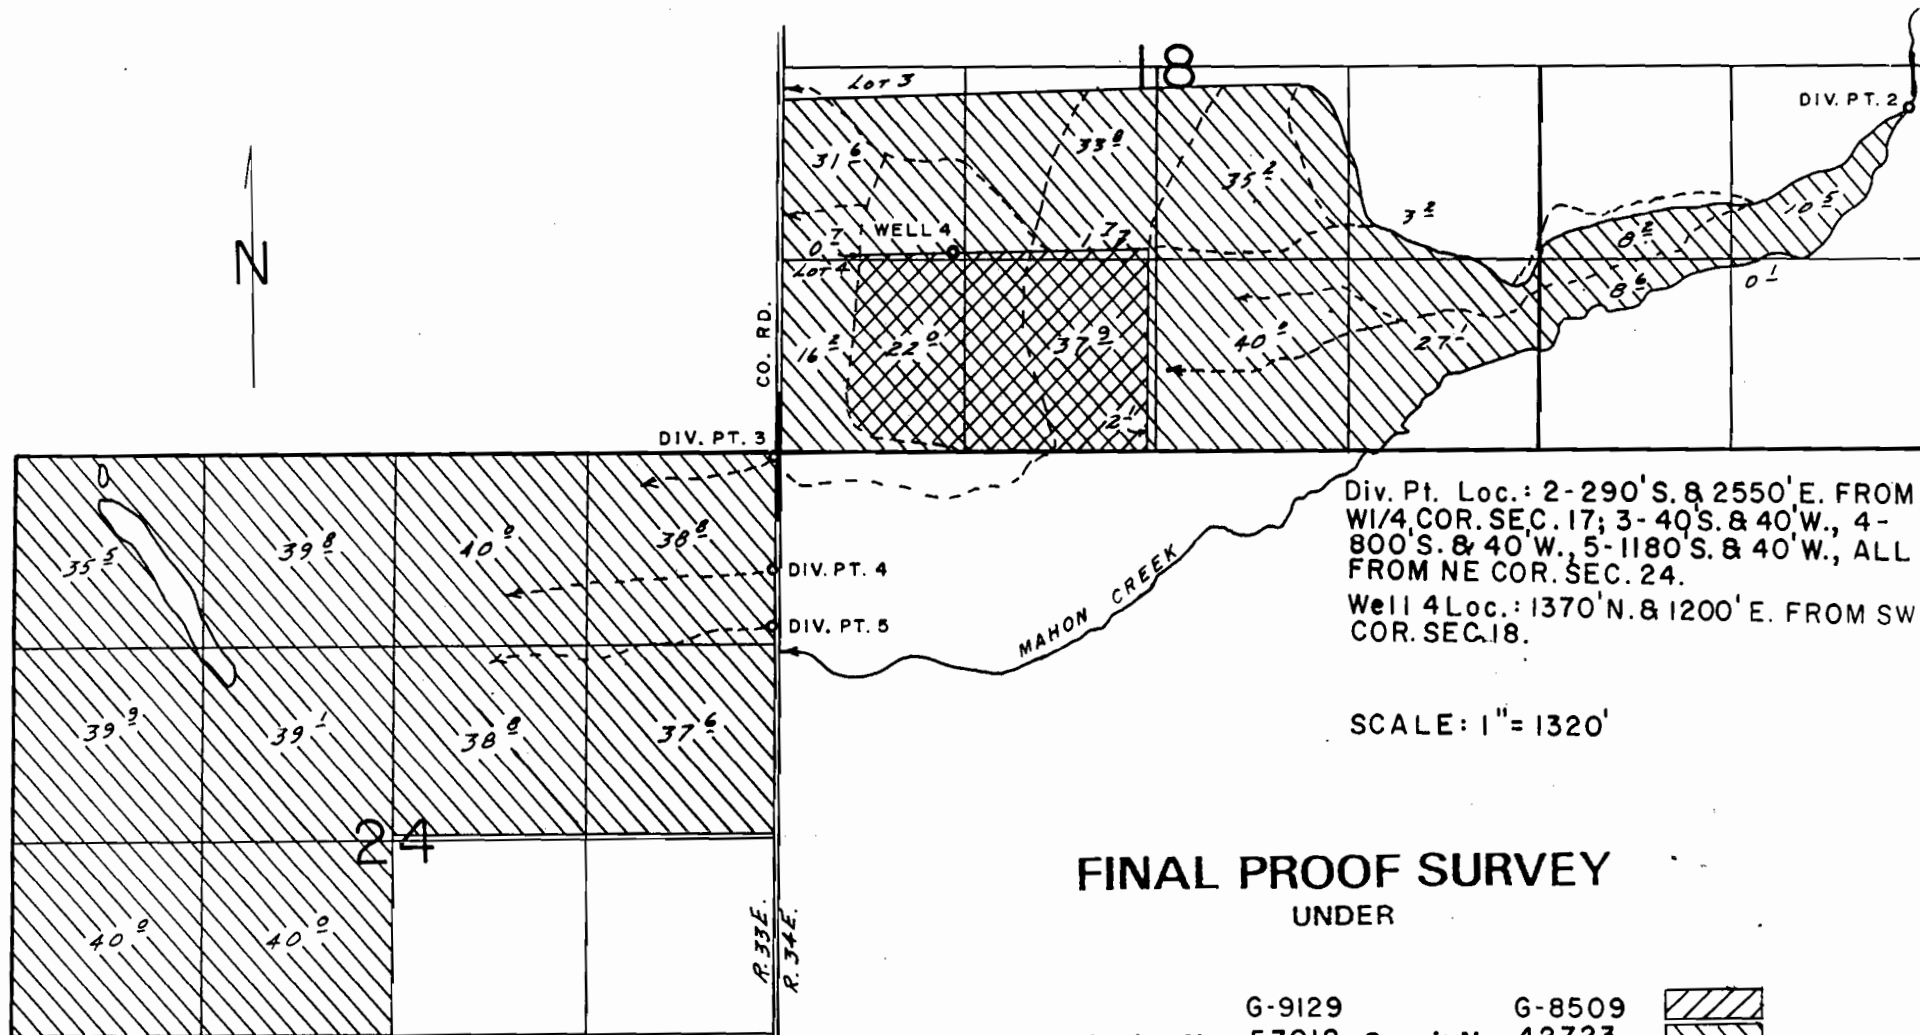

FINAL PROOF SURVEY UNDER

G-9129 G-8509
Application No. 57018... Permit No. 42723...
IN NAME OF

JOE R. & DAVID W. ARNOLD

Surveyed MAY 16... 1988, by Z. E. SALEH