


N

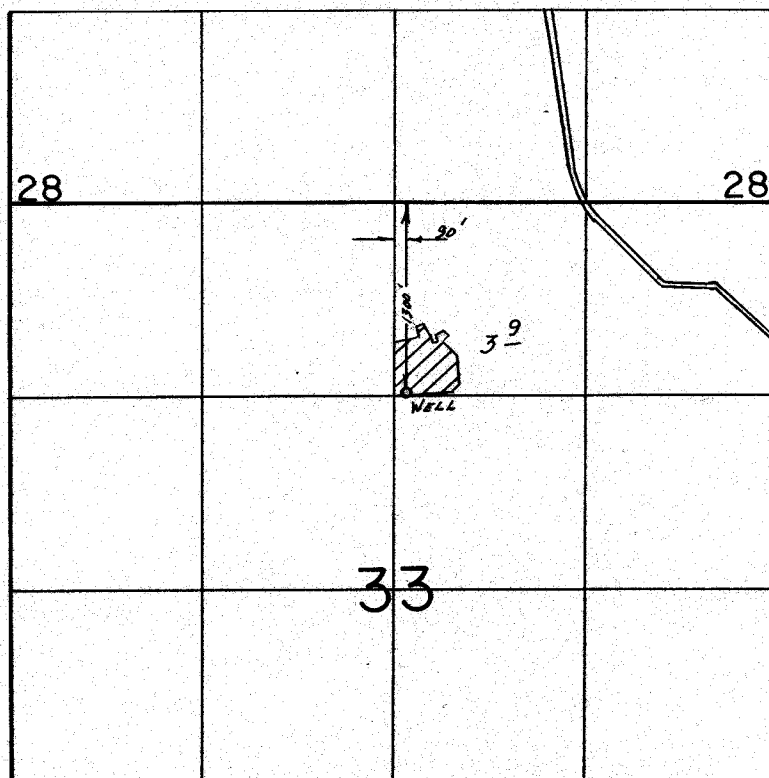

FINAL PROOF SURVEY

UNDER

PAUL A. ERICKSON

Surveyed June 16, 1988, by Y.L. CHURCH...

4/11/89 RWD

41023-279-8D