


T. 10S., R. 14E., W.M.

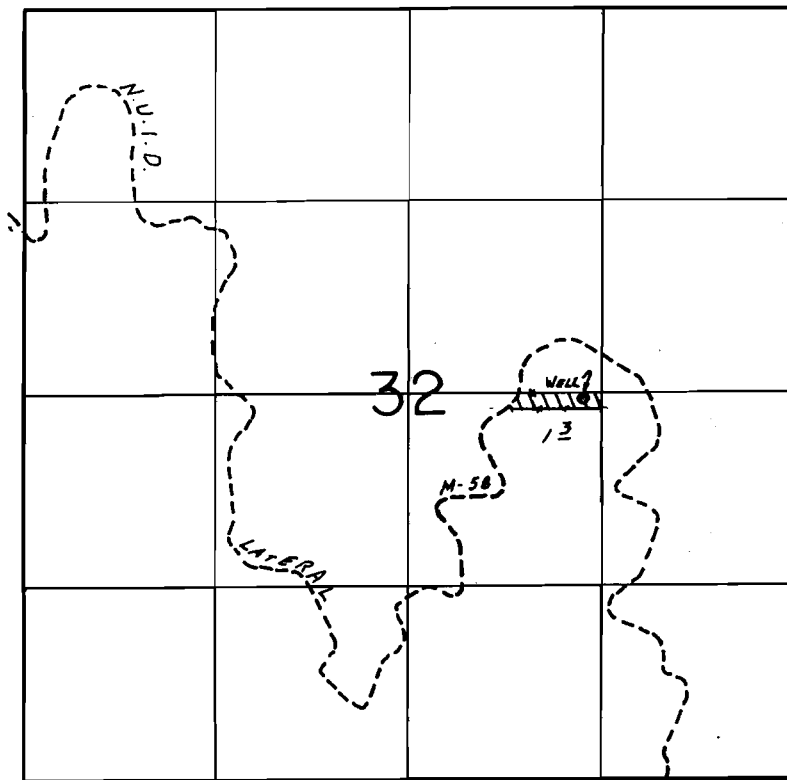

WELL LOC.: 40'S. & 1180'E. FROM C. 1/4 COR. SEC. 32.

SCALE: 1" = 1320'

FINAL PROOF SURVEY
UNDER

Application No. G-9693 Permit No. G-9337.....
IN NAME OF

.....**DELWIN E. WISEMAN**.....

Surveyed April 5... 1988... by B.W. BISHOP.....

Cent. # 66514

Rec'd 7-29-91 WD#41

1/9/89 FWB

41031-179-90R

69337