


T. 38 & 39 S., R. 5 W., W.M.

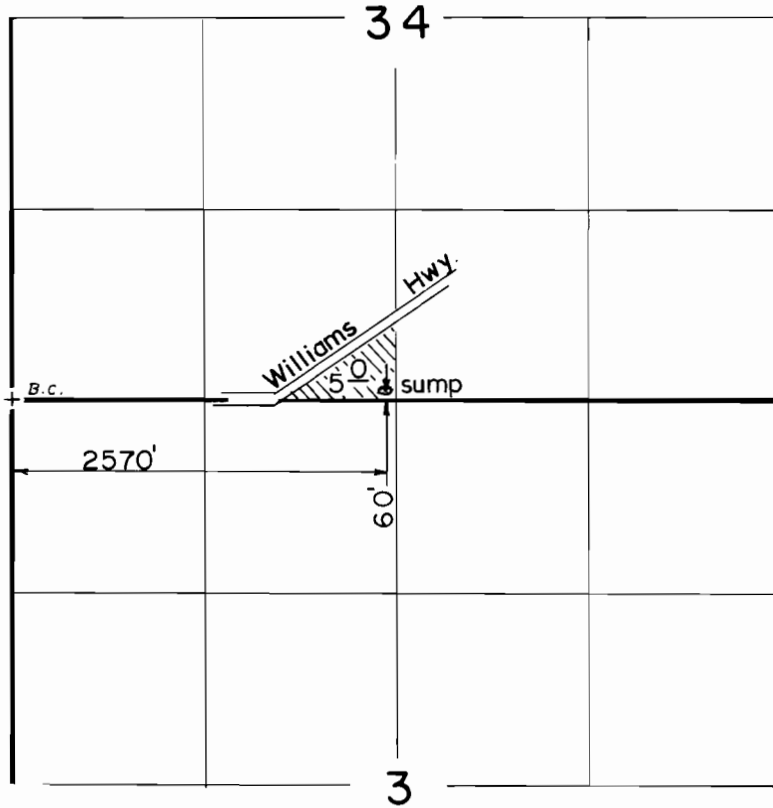

Scale: 1" = 1320'

**FINAL PROOF SURVEY**  
UNDER

Application No. G-9725 Permit No. G-917.7  
IN NAME OF

ROGER L. PREFONTAINE

Surveyed JUL 13 1988, by B.S. JAMES