


T.24S., R.5W., W.M.

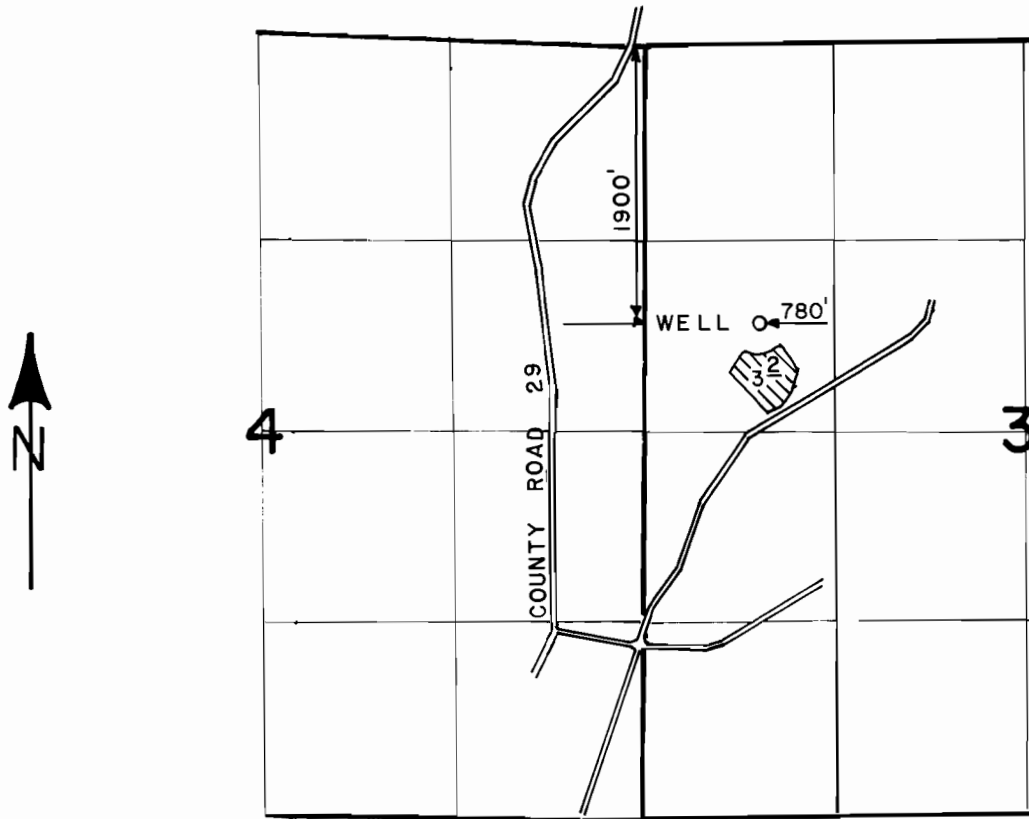

SCALE : 4" = 1 MILE

FINAL PROOF SURVEY
UNDER

Application No. G-9803 Permit No. G-8995
IN NAME OF

DENNIS D. MEEUWSER

Surveyed AUG. 18, 1988, by J. M. SCHMORDE